

This form shall be filed in duplicate with the Kansas Corporation Commission, 200 Colorado Derby Building, Wichita, Kansas 67202, within ten days after the completion of the well, regardless of how the well was completed.

Attach separate letter of request if the information is to be held confidential. If confidential, only file one copy. Information on side one will be of public record and side two will then be held confidential.

Circle one: Oil Gas, Dry, SWD, OWWO, Injection. Type and complete ALL sections. Applications must be filed for dual completion, commingling, SWD and injection, T.A.

Attach wireline logs (i.e. electrical log, sonic log, gamma ray neutron log, etc.). KCC # (316) 263-3238. (Rules 82-2-105 & 82-2-125)

OPERATOR Graham-Michaelis Corporation

API NO. 15-051-22,668-00-00

ADDRESS P. O. Box 247

COUNTY Ellis

Wichita, Kansas 67201

FIELD Pfeifer-Shawnee

**CONTACT PERSON Jack L. Yinger

PROD. FORMATION Lansing

PHONE 264-8394

LEASE Disney "B"

PURCHASER Koch Oil Company

WELL NO. 1 - 18

ADDRESS P. O. Box 2256

WELL LOCATION SW SE NE

Wichita, Kansas 67201

2340 Ft. from North Line and

DRILLING Revlin Drilling, Inc.

940 Ft. from East Line of

CONTRACTOR

ADDRESS P. O. Box 88

the NE/4 SEC. 18 TWP. 13S RGE. 19W


Russell, Kansas 67665

WELL PLAT

PLUGGING

CONTRACTOR

ADDRESS

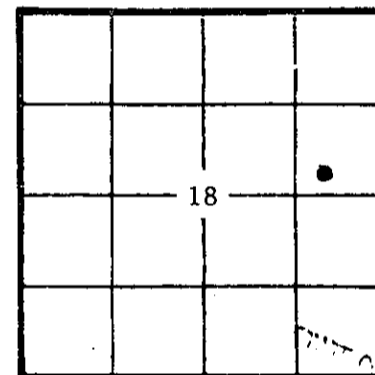

KCC
KGS
(Office Use)

TOTAL DEPTH 3790' PBSD 3695'

SPUD DATE 10-22-81 DATE COMPLETED 11-19-81

ELEV: GR 2069 DF 2071 KB 2074

DRILLED WITH (XXXX) (ROTARY) (XXXX) TOOLS

Amount of surface pipe set and cemented 347' DV Tool Used? Yes

AFFIDAVIT

STATE OF Kansas, COUNTY OF Sedgwick SS, I,

Jack L. Yinger OF LAWFUL AGE, BEING FIRST DULY SWORN UPON HIS OATH,

DEPOSES THAT HE IS Vice President (FOR)(OF) Graham-Michaelis Corporation

OPERATOR OF THE Disney "B" LEASE, AND IS DULY AUTHORIZED TO MAKE

THIS AFFIDAVIT FOR AND ON THE BEHALF OF SAID OPERATOR, THAT WELL NO. 1 - 18 ON

SAID LEASE HAS BEEN COMPLETED AS OF THE 19th DAY OF November, 19 81, AND THAT

ALL INFORMATION ENTERED HEREIN WITH RESPECT TO SAID WELL IS TRUE AND CORRECT.

FURTHER AFFIANT SAITH NOT.

Handwritten signature of Jack L. Yinger

SUBSCRIBED AND SWORN BEFORE ME THIS 15th DAY OF January, 19 82.

ALDINE M. JOHNSON
NOTARY PUBLIC
STATE OF KANSAS

Handwritten signature of Aldine M. Johnson
NOTARY PUBLIC

MY COMMISSION EXPIRES: March 19, 1985

**The person who can be reached by phone regarding any questions concerning this information. Within 45 days of completion, a witnessed initial test by the Commission is required if the well produces more than 25 BOPD or is located in a Basic Order Pool.

PLEASE KEEP THIS INFORMATION CONFIDENTIAL