

CARD MUST BE TYPED

State of Kansas

CARD MUST BE SIGNED

NOTICE OF INTENTION TO DRILL

(see rules on reverse side)

Expected Spud Date... February 15, 1988
month day year

API Number 15-195-21,965-00-00

OPERATOR: License # 3506
Name NYE EXPLORATION Inc.
Address 3920 East Elm - Suite 4
City/State/Zip Wichita, Kansas 67208
Contact Person Tom Nye
Phone 316/685-3920

NW NW SE Sec 36 Twp 13 S, Rg 22 X East
2310 Ft. from South Line of Section
2310 Ft. from East Line of Section

(Note: Locate well on Section Plat on reverse side)

CONTRACTOR: License # 5864
Name LOBO DRILLING COMPANY
City/State Great Bend, Kansas 67530

Nearest lease or unit boundary line 330 feet
County Trego
Lease Name C. J. Weber Well # 1

Well Drilled For: Well Class: Type Equipment:
X Oil Storage X Infield X Mud Rotary
Gas Inj Pool Ext Air Rotary
OWWO Expl Wildcat Cable

Ground surface elevation feet MSL
Domestic well within 330 feet: yes X no
Municipal well within one mile: yes X no

If OWWO: old well info as follows:

Operator
Well Name
Comp Date Old Total Depth

Depth to bottom of fresh water 100
Depth to bottom of usable water 950
Surface pipe by Alternate: 1 2 X
Surface pipe planned to be set 260
Conductor pipe required
Projected Total Depth 4150 feet
Formation

I certify that well will comply with K.S.A. 55-101, et seq., plus eventually plugging hole to KCC specifications.

Date 2/10/88 Signature of Operator or Agent Thomas J. Nye Title PRESIDENT

For KCC Use:

Conductor Pipe Required feet; Minimum Surface Pipe Required 200 feet per Alt. (1) ✓
This Authorization Expires 8-11-88 Approved By Thomas J. Nye RCH 2-11-88


DATE: 2-16-88

Must be filed with the K.C.C. five (5) days prior to commencing well
This card void if drilling not started within six (6) months of date received by K.C.C.

Important procedures to follow:

1. Notify District office before setting surface casing.
2. Set surface casing by circulating cement to the top.
3. File completion forms ACO-1 with K.C.C. within 120 days of well spud date, following instructions on ACO-1, side 1, and including copies of wireline logs.
4. Notify District office 48 hours prior to old well workover or re-entry.
5. Prior to filing Intent, prepare a proposed plugging plan in case well is D & A, then obtain approval of plan when calling district office prior to setting surface pipe.
6. Submit plugging report (CP-4) to K.C.C. after plugging is completed.
7. Obtain an approved injection docket number before disposing of salt water.
8. Notify K.C.C. within 10 days when injection commences or terminates.
9. If an alternate cement in the production pipe from below any usable water to surface within 120 days of spud date.

A Regular Section of Land
1 Mile = 5,280 Ft.

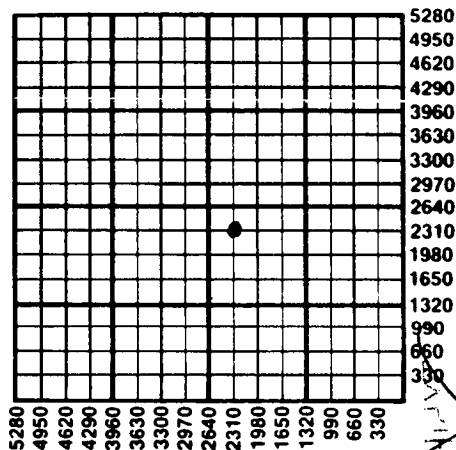

~~VOID~~
11-11-88
RWP

State Corporation Commission of Kansas
Conservation Division
200 Colorado Derby Building
Wichita, Kansas 67202-1212
Wichita, Kansas (316) 263-3238