


15 051 30404 0000
WELL PLUGGING RECORD

Give All Information Completely
Make Required Affidavit
Mail or Deliver Report to:
Conservation Division
State Corporation Commission
212 No. Market
Wichita, Kansas

Ellis County, Sec. 4 Twp. 13S Rge. (E) 17 (W)

Location as "NE/CNW&SW" or footage from lines S/2 SE NE NW
Lease Owner Tomlinson-Kathol Inc.
Lease Name Wolf # 1 Well No. 1
Office Address 1125 Wichita Plaza, Wichita, Kansas
Character of Well (completed as Oil, Gas or Dry Hole) dry hole
Date well completed 12-21-1966
Application for plugging filed 12-21-1966
Application for plugging approved 12-21-1966
Plugging commenced 11-30 P. M. 12-20-1966
Plugging completed 3:00 AM 12-21-1966
Reason for abandonment of well or producing formation Dry

NORTH

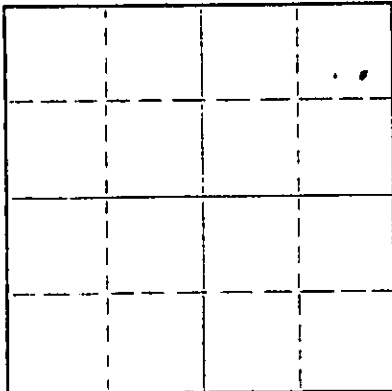

Locate well correctly on above
Section Plat

If a producing well is abandoned, date of last production none 19
Was permission obtained from the Conservation Division or its agents before plugging was commenced? yes

Name of Conservation Agent who supervised plugging of this well Leo Massey - Hays, Kansas
Producing formation none Depth to top Bottom Total Depth of Well Feet
Show depth and thickness of all water, oil and gas formations.

OIL, GAS OR WATER RECORDS

CASING RECORD

FORMATION	CONTENT	FROM	TO	SIZE	PUT IN	PULLED OUT
Soil & Clay		0	186	8 3/4	186	none

Describe in detail the manner in which the well was plugged, indicating where the mud fluid was placed and the method or methods used in introducing it into the hole. If cement or other plugs were used, state the character of same and depth placed, from feet to feet for each plug set.

Filled hole to 180' - Ran 30 stands in hole - Lay down same
Fluid at 100' - Set plug at 540' with 20 sacks through pipe - Hole
filled to 150' - plug & hulls & spot 20 sacks pipe - Fill hole to
40' Bridge to hold kelly wt with 10 sacks. Plugged rat hole with
2 sacks.

12-29-66

(If additional description is necessary, use BACK of this sheet)

Name of Plugging Contractor B & B Drilling Inc.
Address 548 Petroleum Building- Wichita, Kansas

STATE OF Kansas, COUNTY OF Sedgwick, ss.
Bill Lahar (employee of owner) or (owner or operator) of the above-described well, being first duly sworn on oath, says: That I have knowledge of the facts, statements, and matters herein contained and the log of the above-described well as filed and that the same are true and correct. So help me God.

(Signature) Bill Lahar
548 Petroleum Building- Wichita, Kansas
(Address)

SUBSCRIBED AND SWORN TO before me this 27th day of December, 1966

Alma A. Neiser
Notary Public.

My commission expires May 31, 1970

B & B DRILLING, INC.

548 Petroleum Building
Wichita, Kansas 67202

15-051-30404-00-00

December 27, 1966

DRILLERS LOG

Re: Wolf #1
SE NE NW
Section 4-13S-17W
Ellis County, Kansas

COMPANY: Tomlinson-Kathol Inc.
CONTRACTOR: B & B Drilling Inc.
TOTAL DEPTH: 3620'
COMMENCED: December 16, 1966
COMPLETED: December 26, 1966

0	45	Soil & Clay
45	168	Shale
188	755	Shale & Clay
755	895	Shale & Sand
895	925	Red Bed
1291	1682	Shale
1682	2030	Shale & Shells
2059	2090	Shale & Lime
2090	2205	Shale
2205	2336	Lime & Shale
2336	2625	Shale & Lime
2625	2820	Shale & Lime
2820	2860	Shale
2860	2945	Lime & Shale
2945	3145	Shale & Lime
3145	3230	Lime & Shale
3230	3335	Lime
3335	3415	Lime
3415	3450	Lime & Shale
3450	3540	Lime
3540	3574	Lime & Shale
3574	3600	Conglomerate
3600	3620	Conglomerate
3620		Total Depth

RECEIVED
STATE OF KANSAS COMMISSIONER

DEC 29 1966

COMMISSIONER DIVISION
WICHITA, KANSAS

We certify the above and foregoing to be true and correct copy of the log on the #1 Wolf, located in Ellis County, Kansas

B & B DRILLING INC.

Bill Lubar President

Alma A. Neiser Notary Public
Subscribed and sworn to before me this
27th day of December, My commission expires
May 31, 1970