


STATE OF KANSAS
STATE CORPORATION COMMISSION

WELL PLUGGING RECORD 15-051-22633-00-00

Give All Information Completely
Make Required Affidavit
Mail or Deliver Report to
Conservation Division
State Corporation Comm.
245 North Water
Wichita, KS 67202

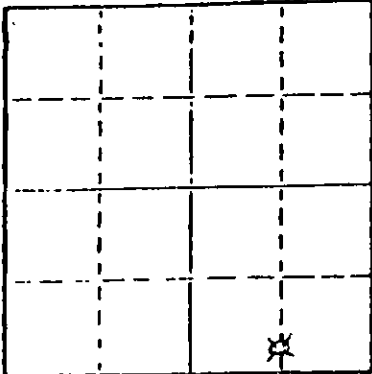

Locate well correctly on above
Section Plat

Ellis County, Sec. 4 Twp. 13S Rge. 17W E/W
Location as "NE/CNW $\frac{1}{4}$ SW $\frac{1}{4}$ " or footage from lines
App S $\frac{1}{2}$ S $\frac{1}{2}$ SE
Lease Owner Thomas W. Wiesner
Lease Name Thomas Dean Walters Well No. #1
Office Address 3007 Indian Trl Hays, Ks. 67601
Character of Well (Completed as Oil, Gas or Dry Hole)

Dry Hole

Date Well completed 10-14 1981
Application for plugging filed 10-14 1981
Application for plugging approved 10-14 1981
Plugging commenced 10-14 1981
Plugging completed 10-14 1981
Reason for abandonment of well or producing formation

Dry Hole

If a producing well is abandoned, date of last production 19

Was permission obtained from the Conservation Division or
its agents before plugging was commenced? Yes

Name of Conservation Agent who supervised plugging of this well Gilbert Scheck
Producing formation Depth to top Bottom Total Depth of Well 3695'
Show depth and thickness of all water, oil and gas formations.

OIL, GAS OR WATER RECORDS

CASING RECORD

FORMATION	CONTENT	FROM	TO	SIZE	PUT IN	PULLED OUT
Surface		0	210'	8 5/8"	210'	0

Describe in detail the manner in which the well was plugged, indicating where the mud fluid
was placed and the method or methods used in introducing it into the hold. If cement or other
plugs were used, state the character of same and depth placed, from feet to
feet for each plug set.

1st. Plug set at 700' with 70 sacks common cement 50-50 poz 3%Cal Cl 4%gel

2nd. Plug set at 210' with 40 sacks common cement 50-50poz 3%Cal Cl 4%gel

3rd. Plug set at 40' with 10 sacks common cement 50-50poz 3%Cal Cl 4%Gel

Heavy drilling mud between each plug.

(If additional description is necessary, use BACK of this sheet)

Name of Plugging Contractor Halliburton

STATE OF Kansas COUNTY OF Graham, ss.
Jerry M. Hälberg (employee of owner) or (owner or operator)
of the above-described well, being first duly sworn on oath, says: That I have knowledge of
the facts, statements, and matters herein contained and the log of the above-described well
as filed and that the same are true and correct. So help me God

(Signature)

Box 32 Morland, Kansas 67650

(Address)

SUBSCRIBED AND SWORN TO before me this 26 day of Nov., 1981

My commission expires Dec 1, 1983

Notary Public.

STATE OF KANSAS

10-27-81
CO. 5
Wichita, Kansas

DRILLERS LOG

WALTERS #1

CASING RECORD:

8 5/8" set at 210'

TOTAL DEPTH:

3695'

DESCRIPTION:

App S½ S½ SE,

Sec. 4, Twp. 13S, Rge. 17W.

OPERATOR: Thomas W. Wiesner

CONTRACTOR: Helberg Oil Company

COMMENCED: October 5, 1981

COMPLETED: October 14, 1981

15-051-22633-00-00			
FORMATION	FROM	TO	REMARKS
Sand & Shale	0	20	
Sand & Shale	20	226	
Sand & Shale	226	390	
Sand & Shale	390	1175	
Sand & Shale	1175	1482	
Anhydrite	1239		
Shale	1482	1900	
Lime & Shale	1900	2100	
Lime & Shale	2100	2218	
Shale	2218	2342	
Lime & Shale	2342	2500	
Shale	2500	2651	
Shale	2651	2773	
Lime & Shale	2773	2885	
Lime & Shale	2885	3037	
Lime & Shale	3037	3165	
Lime & Shale	3165	3264	
Lime & Shale	3264	3355	
Lime	3355	3415	
Lime	3415	3430	
Lime	3430	3446	
Lime	3446	3517	
Lime	3517	3605	
Lime	3605	3630	
Lime	3630	3641	
Lime	3641	3695	
T.D.	3695		D&A

I certify that the above is a true and correct copy of the log to the best of my knowledge.

Helberg Oil Company

Jerry M. Helberg
Jerry M. Helberg

Subscribed and sworn to before me this 26 day of Oct., 1981.

James L. Helberg
Notary Public

My commission expires Dec. 4, 1983