

STATE OF KANSAS  
STATE CORPORATION COMMISSION


Give All Information Completely  
Make Required Affidavit  
Mail or Deliver Report to:  
Conservation Division  
State Corporation Commission  
800 Bitting Building  
Wichita, Kansas

OR

Strike out upper line  
when reporting plug-  
ging off formations.

~~FORMATION PLUGGING RECORD~~

NORTH

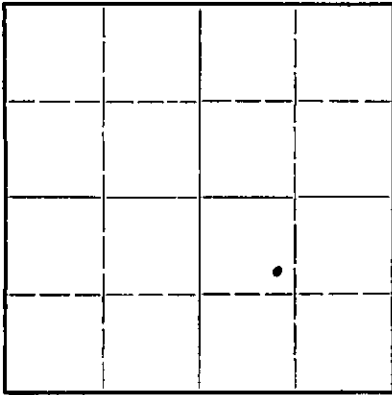

Locate well correctly on above  
Section Plot

Ellis County. Sec. 4 Twp 13S Rge. 17W (E) (W)  
Location as "NE $\frac{1}{4}$ NW $\frac{1}{4}$ SW $\frac{1}{4}$ " or footage from lines. SE. N. 1. S.  
Lease Owner Ashland Oil & Refining Co.  
Lease Name Walter Well No. 2  
Office Address 308 National Bank of Tulsa Bldg., Tulsa, Okla.  
Character of Well (completed as Oil, Gas or Dry Hole) Dry Hole  
Date well completed 11-16-19 45  
Application for plugging filed 11-23-19 45  
Application for plugging approved 19  
Plugging commenced 11-16-19 45  
Plugging completed 11-16-19 45  
Reason for abandonment of well or producing formation. Dry Hole

If a producing well is abandoned, date of last production 19  
Was permission obtained from the Conservation Division or its agents before plugging was com-  
menced? Yes

Name of Conservation Agent who supervised plugging of this well. H. W. Kerr  
Producing formation. None Depth to top Bottom Total Depth of Well. 3650 Feet  
Show depth and thickness of all water, oil and gas formations.

OIL, GAS OR WATER RECORDS


CASING RECORD

Formation	Content	From	To	Size	Put In	Pulled Out
				8-5/8" OD	1238	None

Describe in detail the manner in which the well was plugged, indicating where the mud fluid was placed and the method or methods used in introducing it into the hole. If cement or other plugs were used, state the character of same and depth placed, from feet to feet for each plug set.

Filled hole w/ mud laden fluid to 1238'. Placed 15 sacks cement in bottom of surface casing at 1238'. Filled w/ mud laden fluid to 25'. Placed 10 sacks cement in top of surface casing.

4 13 1945  
34

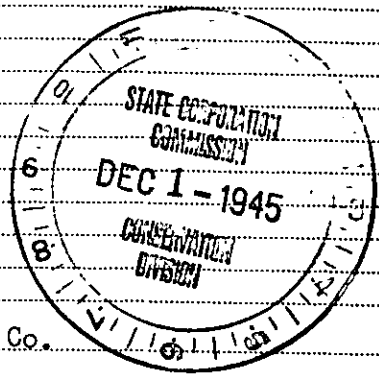

(If additional description is necessary, use BACK of this sheet)  
Correspondence regarding this well should be addressed to Ashland Oil & Refining Co.  
Address 308 Natl Bk of Tulsa Bldg.

STATE OF OKLAHOMA, COUNTY OF TULSA, ss.  
E. D. Bates (employee of owner) or (owner or operator) of the above-described well,  
being first duly sworn on oath, says: That I have knowledge of the facts, statements, and matters herein contained and the log of the above-described well as filed and that the same are true and correct. So help me God.

(Signature) E D Bates

(Address)

SUBSCRIBED AND SWORN to before me this 27th day of November, 1945

Mrs. Louise Brooke  
Notary Public.

My commission expires Aug. 23, 1948

Ashland Oil and Refining Company  
Tulsa 3, Oklahoma

Walters Well No. 2

SE NW SE  
Sec. 4-13S-17W  
Ellis County, Kansas

Contractor: Goodpaster Drilling Company

15051-04497-00-00

0-1238	Top of Anhydrite 1233'	8 5/8" Surface pipe cemented W/ 400 sxs.
1275-1610	Redbed	
1610-1655	Shale & Shells	
1655-1670	Lime	
1670-2180	---Shale lime & Shells	
2180-2420	---Lime	
2420-2455	Shale & Shells	
2455-3075	Lime & Shale	
3075-3280	Lime	
3280-3294	Shale	
3294-3625	Lime	
3625-3650	Conglomerate	
3650	Total depth	Well plugged and abandoned with 2w/15sxs cement in bottom of surface pipe 1238' to sxs cement in top of surface pipe.

I, Herbert Goodpaster, do hereby testify that the above is a true and complete log of the Walters Well No. 2, located in the SE NW SE Quarter, Sec. 4-13S-17W, Ellis County, Kansas.

November 16, 1945

4 13 17W  
34 1

