


15-051-30101-00-00  
WELL PLUGGING RECORD

Give All Information Completely  
Make Required Affidavit  
Mail or Deliver Report to:  
Conservation Division  
State Corporation Commission  
211 No. Broadway  
Wichita, Kansas

Ellis County, Sec. 4 Twp. 13S Rge. 17W (E) (W)  
Location as "NE/CNW&SW&" or footage from lines SE NW NE  
Lease Owner Frontier Oil Company  
Lease Name Madden Well No. 6  
Office Address 1720 Wichita Plaza, Wichita, Kansas  
Character of Well (completed as Oil, Gas or Dry Hole) Dry Hole  
Date well completed August 12, 19 65  
Application for plugging filed August 12, 19 65  
Application for plugging approved August 12, 19 65  
Plugging commenced August 12, 19 65  
Plugging completed August 12, 19 65  
Reason for abandonment of well or producing formation D & A

NORTH

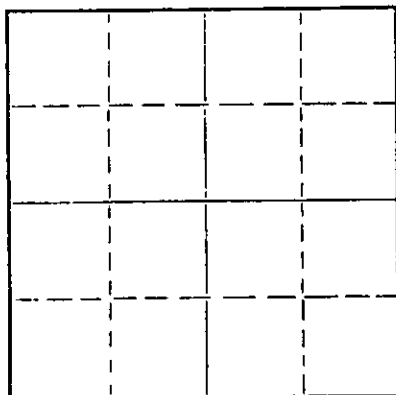

Locate well correctly on above  
Section Plat

If a producing well is abandoned, date of last production 19  
Was permission obtained from the Conservation Division or its agents before plugging was commenced? Yes

Name of Conservation Agent who supervised plugging of this well Eldon Petty  
Producing formation \_\_\_\_\_ Depth to top \_\_\_\_\_ Bottom \_\_\_\_\_ Total Depth of Well 3622 Feet  
Show depth and thickness of all water, oil and gas formations.

OIL, GAS OR WATER RECORDS

CASING RECORD

FORMATION	CONTENT	FROM	TO	SIZE	PUT IN	PULLED OUT
				8 5/8"	199'	-0-

Describe in detail the manner in which the well was plugged, indicating where the mud fluid was placed and the method or methods used in introducing it into the hole. If cement or other plugs were used, state the character of same and depth placed, from \_\_\_\_\_ feet to \_\_\_\_\_ feet for each plug set.

Plug @ 540' + 1/4 sx hulls + 20 sx cement  
Plug @ 180' + 1/4 sx hulls + 20 sx cement  
Plug @ 40' + 1/4 sx hulls + 10 sx cement

RECEIVED  
STATE CORPORATION COMMISSION

AUG 17 1965

CONSERVATION DIVISION  
Wichita, Kansas

(If additional description is necessary, use BACK of this sheet)  
Name of Plugging Contractor Red Tiger Drilling Company  
Address Box 173 -- Russell, Kansas

STATE OF KANSAS, COUNTY OF SEDGWICK, ss.  
George A. Angle (employee of owner) or (owner or operator) of the above-described well, being first duly sworn on oath, says: That I have knowledge of the facts, statements, and matters herein contained and the log of the above-described well as filed and that the same are true and correct. So help me God.

(Signature) George A. Angle  
1720 Wichita Plaza, Wichita, Kansas  
(Address)

SUBSCRIBED AND SWORN TO before me this 16th day of August, 19 65

Jean Hollan

My commission expires 5-22-66

Notary Public.

DRILLERS LOG

Madden No. 6

CASING RECORD: 8 5/8" @ 199' w/135 sx cement

COMPANY: Frontier Oil Company

CONTRACTOR: Red Tiger Drilling Company

COMMENCED: August 4, 1965

COMPLETED: August 12, 1965

DESCRIPTION: SE NW NE  
4-13S-17W  
Ellis Co., Ks.

ELEVATION: 2058 DF  
2061 RB

TOTAL DEPTH: 3622'

15:05 / 30/01/20:00

<u>FORMATION</u>	<u>FROM</u>	<u>TO</u>	<u>REMARKS</u>
Surface	0	200	
Shale & Shells	200	580	
Sand	580	650	
Shale & Shells	650	1185	
Redbed	1185	1250	
Anhydrite	1250	1285	
Shale & Shells	1285	1975	
Shale & Lime	1975	3370	
Lime	3370	3579	
Lime & Conglomerate	3579	3622	

RECEIVED  
STATE CORPORATION COMMISSION  
AUG 17 1965  
CONSERVATION DIVISION  
Wichita, Kansas

I certify that this is a true and correct copy of the above log to the best of my knowledge.

FRONTIER OIL COMPANY

George A. Angle  
George A. Angle

Subscribed and sworn to before me this 16th day of August, 1965.

Jean Bellard  
Notary Public

My Commission Expires:

5-22-66