


STATE OF KANSAS
STATE CORPORATION COMMISSION

Give All Information Completely
Make Required Affidavit
Mail or Deliver Report to:
Conservation Division
State Corporation Commission
212 North Market, Insurance Bldg.
Wichita, Kansas

15-057-04668-00:00
WELL PLUGGING RECORD

NORTH

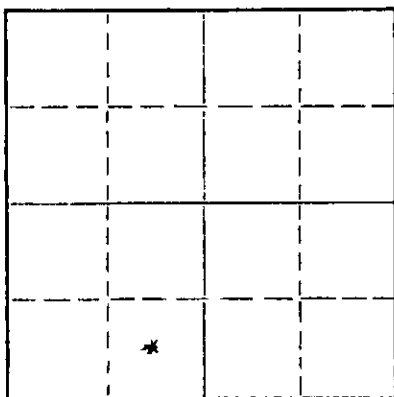

Locate well correctly on above
Section Flat

Ellis County. Sec. 4 Twp. 13 Rge. 17 (E) (W)
Location as "NE/CNW/SE/SW" or footage from lines C SE SW SW
Lease Owner M. J. Boye et al
Lease Name Wolf Well No. 3
Office Address 754 East Wichita, Russell, Kansas
Character of Well (completed as Oil, Gas or Dry Hole) dry hole
Date well completed 8-9 19 61
Application for plugging filed 8-9 19 61
Application for plugging approved 8-9 19 61
Plugging commenced 8-9 19 61
Plugging completed 8-9 19 61
Reason for abandonment of well or producing formation dry hole

If a producing well is abandoned, date of last production _____ 19____
Was permission obtained from the Conservation Division or its agents before plugging was commenced? Yes

Name of Conservation Agent who supervised plugging of this well Eldon Petty
Producing formation _____ Depth to top _____ Bottom _____ Total Depth of Well 3610 Feet
Show depth and thickness of all water, oil and gas formations.

OIL, GAS OR WATER RECORDS

CASING RECORD

FORMATION	CONTENT	FROM	TO	SIZE	PUT IN	PULLED OUT
Surface Pipe		-0-	202'	10 3/4"	202	-0-

Describe in detail the manner in which the well was plugged, indicating where the mud fluid was placed and the method or methods used in introducing it into the hole. If cement or other plugs were used, state the character of same and depth placed, from _____ feet to _____ feet for each plug set.

Filled hole with heavy rotary mud.
Set bottom plug at 500' with 1/4 sack hulls on top.
Cemented with 20 sacks cement.
Set plug at 180' with 1/4 sack hulls on top.
Cemented with 20 sacks cement.
Set top plug at 40'. Cemented with 10 sacks.

STATE CORPORATION COMMISSION
AUG 21 1961
CONSERVATION DIVISION
Wichita, Kansas

(If additional description is necessary, use BACK of this sheet)
Name of Plugging Contractor C. L. Miles d/b/a A. L. Jackson Drilling Company
Address P. O. Box 339, Great Bend, Kansas

STATE OF Kansas COUNTY OF Barton ss.
C. L. Miles, contractor on (complete name of contractor) of the above-described well, being first duly sworn on oath, says: That I have knowledge of the facts, statements, and matters herein contained and the log of the above-described well as filed and that the same are true and correct. So help me God.

(Signature) C. L. Miles
P. O. Box 339, Great Bend, Kansas
(Address)

SUBSCRIBED AND SWORN TO before me this 14th day of August, 19 61

My commission expires December 3, 1963
Jean Limber Notary Public.



W E L L L O G
 Wolf # 3
 C SE SW SW 4-13S-17W
 Ellis County, Kansas

15051046680000

From	To		<u>Elevation</u>	<u>2047' DF</u>
0	202	Surface clay & Shale		
202	755	Shale & Sand		
755	920	Sand		
920	1090	Shale & Shells		
1090	1165	Red Bed	Kansas City	3337
1165	1245	Red bed & Shale	Arbuckle	3595
1245	1295	Anhydrite		
1295	1408	Shale & Shells		
1408	1960	Shale		
1960	2215	Shale & Lime		
2215	2457	Lime		
2457	3190	Lime & Shale		
3190	3610	Lime		
3610		T.D.		

STATE OF KANSAS
 COUNTY OF BARTON ss

C. L. Miles d/b/a A. L. Jackson Drilling Company, being first duly sworn on oath says: That I have knowledge of the facts, statements and matters herein contained and the log of the above described well as filed and that the same are true and correct.

C. L. Miles

 C. L. Miles

Subscribed and sworn before me this 14th day of August, 1961

Dean Limber

 Notary Public Barton County

My Commission Expires: 12-3-63

