

15-051-02679-00-00
WELL PLUGGING RECORD

Information Completely
Required Affidavit
Deliver Report to:
Conservation Division
State Corporation Commission
111 No. Broadway
Wichita, Kansas

Ellis County, Sec. 4 Twp. 13 Rge. 17 (E) W (W)

Location as "NE/CNWKSWK" or footage from lines NE-SE-SW

Lease Owner M.J. Bove

Lease Name Wolfe Well No. 2

Office Address Russell, Kansas

Character of Well (completed as Oil, Gas or Dry Hole) Oil Well

Date well completed May 18, 1955 19

Application for plugging filed March 3, 1963 19

Application for plugging approved March 5, 1963 19


Plugging commenced March 7 19 63

Plugging completed March 9 19 63

Reason for abandonment of well or producing formation _____

If a producing well is abandoned, date of last production _____ 19

Was permission obtained from the Conservation Division or its agents before plugging was commenced? Yes

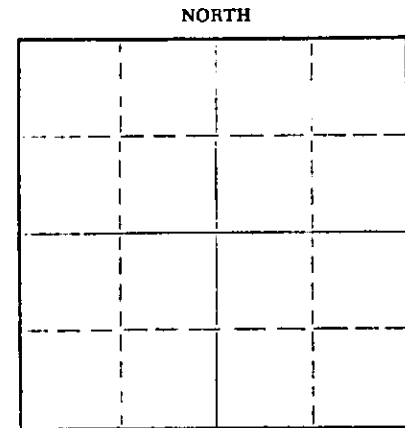

Locate well correctly on above Section Plat

Name of Conservation Agent who supervised plugging of this well Petty

Producing formation L-K-G Depth to top 3346 Bottom 3350 Total Depth of Well 3633 Feet

Show depth and thickness of all water, oil and gas formations.

OIL, GAS OR WATER RECORDS

CASING RECORD

FORMATION	CONTENT	FROM	TO	SIZE	PUT IN	PULLED OUT
L-KC	Oil	3342	3578	8 5/8	202	None
				5 1/2	3555	767

Describe in detail the manner in which the well was plugged, indicating where the mud fluid was placed and the method or methods used in introducing it into the hole. If cement or other plugs were used, state the character of same and depth placed, from 3633 feet to Surface feet for each plug set.

Halliburton Plug set at 3290' Pipe eat up ~~at 750'~~ at 750' pulled pipe from hole, Circ. at 550' with mud pump 20 sacks of cement to 550' also at 200' pump 20 sacks of cement to 200'. Put 10 sacks on top. Well completed.

RECEIVED
STATE CORPORATION COMMISSION

MAR 19 1963

CONSERVATION DIVISION
Wichita, Kansas

(If additional description is necessary, use back of this sheet)
Name of Plugging Contractor Barnes & Sons Pipe Pulling Co.
Address Box 313 Russell, Kansas

STATE OF Kansas, COUNTY OF Russell, ss.
E. T. Drube (employee of owner) owner or operator of the above-described

well, being first duly sworn on oath, says: That I have knowledge of the facts, statements, and matters herein contained and the log of the above-described well as filed and that the same are true and correct. So help me God.

(Signature) E. T. Drube

754 East Wichita, Russell, Kansas

(Address)

SUBSCRIBED AND SWORN TO before me this 15th day of March, 1963

Ruth E. Miller

Notary Public

My commission expires January 5, 1965

NO. 2 Wolf "A"

15051-02679-00-00

Location: NE SE SW, 4-13S-17W
Ellis County, Kansas

Commenced: May 10, 1955

Operator: Graham-Messman-Rinehart Oil Co.
1005 East Second, Wichita, Kansas

Completed: May 18, 1955

Elevation: 2061 KB

Contractor: Graham-Messman-Rinehart Drilling Co.
1005 East Second, Wichita, Kansas

Production:

Casing Record: 8 5/8" @ 202' w/125 Sacks cement
5 1/2" @ 3555' w/60 Sacks cement

.....L O G.....

Clay-Sand	100
Shale	203
Shale-Shells	410
Sand-Shale	760
Sand	900
Shale-Red Bed	1240
Anhydrite	1290
Red Bed-Shale	1570
Shale-Shells	1660
Salt	1850
Shale-Lime	2175
Lime-Shale	2450
Shale-Shells	2500
Shale-Lime	3220
Lime-Shale	3365
Lime	3535
Lime-Conglomerate	3633 R. T. D.

Sample Tons:

Anhydrite	1246 (815)
Toneka	3025 (-964)
Heebner	3273 (-1212)
Toronto	3294 (-1233)
Lansing	3342 (-1281)
Conglomerate	3578 (-1517)

RECEIVED
STATE CORPORATION COMMISSION
MAR 19 1963
CONSERVATION DIVISION
Wichita, Kansas

The undersigned, GRAHAM-MESSMAN-RINEHART DRILLING COMPANY, hereby certifies that the above log is a true and correct log of the formation encountered in drilling the above well as reflected by the Daily Drilling Report.

GRAHAM-MESSMAN-RINEHART DRILLING COMPANY

BY: _____
J. A. Gilliland

Subscribed and sworn to before me this
25th day of May 1955.

Notary Public (Jaunita L. Povich)

My Commission Expires: November 5, 1958