


STATE OF KANSAS
STATE CORPORATION COMMISSION

15-077-20499-0000

WELL PLUGGING RECORD

Give All Information Completely
Make Required Affidavit
Mail or Deliver Report to
Conservation Division
State Corporation Comm.
245 North Water
Wichita, KS 67202

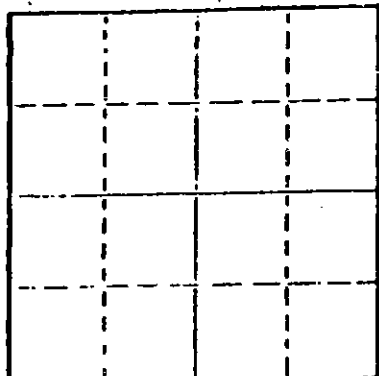

Locate well correctly on above Section Plot

Harper County, Sec. 9 Twp. 32S Rge. 8W E/W
Location as "NE/CNW $\frac{1}{4}$ SW $\frac{1}{4}$ " or footage from lines
C NE SW

Lease Owner Raymond Oil Company
Lease Name Hoyt Well No. 1
Office Address 200 West Douglas, Suite 800, Wichita Ks.
Character of Well (Completed as Oil, Gas or Dry Hole)
Dry

Date Well completed December 1 1978
Application for plugging filed November 30 1978
Application for plugging approved November 30 1978
Plugging commenced December 1 1978
Plugging completed December 1 1978
Reason for abandonment of well or producing formation

Dry
If a producing well is abandoned, date of last production 19

Was permission obtained from the Conservation Division or its agents before plugging was commenced? Yes

Name of Conservation Agent who supervised plugging of this well Bill Owen
Producing formation _____ Depth to top _____ Bottom _____ Total Depth of Well 3660
Show depth and thickness of all water, oil and gas formations.

OIL, GAS OR WATER RECORDS

CASING RECORD

FORMATION	CONTENT	FROM	TO	SIZE	PUT IN	PULLED OUT
		0	262	8 5/8	262	None

Describe in detail the manner in which the well was plugged, indicating where the mud fluid was placed and the method or methods used in introducing it into the hold. If cement or other plugs were used, state the character of same and depth placed, from _____ feet to _____ feet for each plug set.

Plugged, 40 sacks @ 260'
12 sacks @ 40'
3 sacks in rathole. 2 sacks in mousehole
Complete @ 8:00 PM
Cemented by Allied Cement

STATE RECEIVED
STATE CORPORATION COMMISSION
DEC 13 1978
CONSERVATION DIVISION
WICHITA, KANSAS

(If additional description is necessary, use BACK of this sheet)

Name of Plugging Contractor DaMac Drilling Inc.
Box 1164, Great Bend, Kansas 67530

STATE OF Kansas COUNTY OF Barton ss.
Martha J. McKown (employee of owner) or (owner or operator) of the above-described well, being first duly sworn on oath, says: That I have knowledge of the facts, statements, and matters herein contained and the log of the above-described well as filed and that the same are true and correct. So help me God.

(Signature) Martha J. McKown
Box 1164, Great Bend, Kansas 67530
(Address)

Subscribed and sworn to before me this 7th day of December, 1978.

My commission expires 4-28-81

NOTARY PUBLIC
Barton County, Kansas
My Appt. Exp. 4-28-81

Lana J. Rembert
Notary Public.

WELL LOG

15-077-20499-0000

COMPANY Raymond Oil Company

SEC. 9 T. 32S R. 8W

FARM Hoyt

NO. 1

LOC. C NE SW


TOTAL DEPTH 3660'

COUNTY Harper

COMM. 11-24-78

COMP. 12-2-78

CONTRACTOR DaMac Drilling Inc.

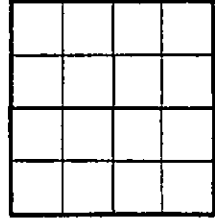

CASING 8 5/8 set @ 262'

ELEVATION

PRODUCTION P&A

FIGURES INDICATE BOTTOM OF FORMATIONS

Sand, RedBed	0	80
RedBed	80	262
RedBed, Shale	262	1160
Shale, Sand	1160	1760
Lime, Shale	1760	3660 RTD

RECEIVED
STATE DEPARTMENT OF CONSERVATION

DEC 18 1978

CONSERVATION DIVISION
STATE DEPARTMENT OF CONSERVATION

State of Kansas }
County of Barton } ss

I, Martha J. McKown of DaMac Drilling Inc.

upon oath state the above and foregoing is a true and correct copy of the log of the Hoyt No. 1 well.

Martha J. McKown

Subscribed and sworn to before me this 7th day of December 19 78

My Commission Expires: 4-28-81

Lamar B. Remment
NOTARY PUBLIC

4-28-81