


Give All Information Completely
Make Required Affidavit
Mail or Deliver Report to:
Conservation Division
State Corporation Commission
212 North Market, Insurance Bldg.
Wichita, Kansas

WELL PLUGGING RECORD

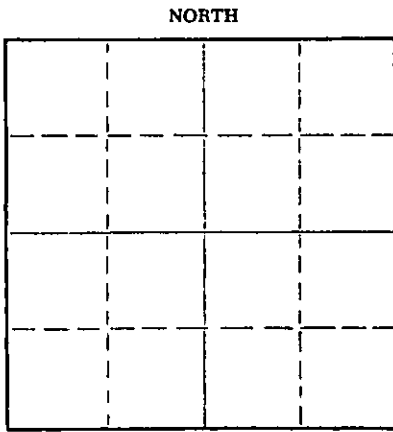

Locate well correctly on above
Section Plat

Stafford County. Sec. 10 Twp. 22 Rge. (E) 14 (W)
Location as "NE/CNW/SW" or footage from lines G S. SE NE
Lease Owner Sunray Mid-Continent Oil Company
Lease Name A. A. Weers Well No. 1
Office Address P. O. Box 788, Great Bend, Kansas
Character of Well (completed as Oil, Gas or Dry Hole) Dry Hole
Date well completed October 26 19 59
Application for plugging filed October 27 19 59
Application for plugging approved October 28 19 59
Plugging commenced October 26 19 59
Plugging completed October 26 19 59
Reason for abandonment of well or producing formation Dry Hole

If a producing well is abandoned, date of last production 19
Was permission obtained from the Conservation Division or its agents before plugging was commenced? Yes

Name of Conservation Agent who supervised plugging of this well Mr. Frank Broadfoot, St. John, Kansas
Producing formation Depth to top Bottom Total Depth of Well 3690 Feet
Show depth and thickness of all water, oil and gas formations.

OIL, GAS OR WATER RECORDS

CASING RECORD

FORMATION	CONTENT	FROM	TO	SIZE	PUT IN	PULLED OUT
Lansing	Dry	3440	3676	8-5/8"	328	None

Describe in detail the manner in which the well was plugged, indicating where the mud fluid was placed and the method or methods used in introducing it into the hole. If cement or other plugs were used, state the character of same and depth placed, from feet to feet for each plug set.

Plug hole with mud to 290'. Set wood plug and 25 sack cement 215'.
Mud to 40'. Set wood plug and 10 sack cement to Surface.
Plugging completed.

RECEIVED
STATE CORPORATION COMMISSION

NOV 5 1959
11-5-59
CONSERVATION DIVISION
Wichita

(If additional description is necessary, use BACK of this sheet)

Name of Plugging Contractor Stickle Drilling Company
Address Tulsa, Oklahoma

STATE OF Kansas, COUNTY OF Barton, ss.
I, James R. Nichols (employee of owner) of the above-described well, being first duly sworn on oath, says: That I have knowledge of the facts, statements, and matters herein contained and the log of the above-described well as filed and that the same are true and correct. So help me God.

(Signature) James R. Nichols
P. O. Box 788, Great Bend, Kansas
(Address)

SUBSCRIBED AND SWORN TO before me this 4th day of November, 19 59

My commission expires December 24, 1960

Notary Public.



Sunray Mid-Continent Oil Company
Tulsa, Oklahoma

15-185-19137-0000

Tulsa, Oklahoma
October 28, 1959

CONTRACTOR: Stickle Drilling Company
Drilling Commenced: October 19, 1959
Drilling Completed: October 26, 1959

A.A. Weers #1 C. of SW/4
SE/4 NE/4 Section 10-22S-
14W, Stafford County, Kansas.

DRILLERS LOG

Depth Figures Indicate Base of Formation:

Surface	0
Sand	175
Shale	330
Shale & Shells	730
Red Bed & Shale	838
Anhydrite	880
Shale & Shells	1700
Shale & Lime	1760
Lime & Shale	1975
Lime & Shale Streaks	2140
Shale & Lime	3030
Lime & Shale	3278
Shale & Lime	3400
Lime & Shale	3690 TD

I, Fred E. Stickle hereby certify the above to be a true and complete Drillers Log of Sunray Mid-Continent Oil Company's A. A. Weers #1 C. of SW/4 SE/4 NE/4 Section 10-22S-14W, Stafford County, Kansas.


Fred E. Stickle


Notary Public

February 13, 1960
My Commission Expires

RECEIVED
STATE CORPORATION COMMISSION

NOV 5 1959

CONSERVATION DIVISION
Wichita, Kansas