KANSAS CORPORATION COMMISSION OIL & GAS CONSERVATION DIVISION

Form CP-1 March 2010 This Form must be Typed Form must be Signed All blanks must be Filled

WELL PLUGGING APPLICATION

Form KSONA-1, Certification of Compilance with the Kansas Surface Owner Notification Act,
MUST be submitted with this form.

OPERATOR: License #: 5427	API Na 15-047-00378-0000
Name: D.R.Lauck Oil.Co. Inc.	If pre 1967, supply original completion date: Sept. 8, 1959
P.O.Box 488	Spot Description:
Address 2: 110 N Main St.	SE NWG SE NE SE TWD 25 S R 16 East West
City: Ellinwood, State: KS. Zip: 67526 +	Feet from North / South Line of Section
Melvin G Urbam	Feet from Esst / West Line of Section
Contact Person:	Footages Calculated from Nearest Outside Section Corner:
Phone: (_620)564=2013	County: Edwards
	Lease Name: Mantey Well #: 3
	Lease Name. Liatting.
Check One: X Oil Well Gas Well GG D&A Cathor	dic Water Supply Well Other:
SWD Permit #: ENHR Permit #:	Gas Storage Permit #:
Conductor Casing Size: Set at:	Cemented with: Sacks
Surface Casing Size: 8 5/8 11 Set at: 3381	
Production Casing Size: 5111 Set at: 44771	
List (ALL) Perforations and Bridge Plug Sets: 4374 to 4382, 4333 to	
43/4 to 4302, 4333 to	4550, 4500 to 4517.
Elevation: 2053 (GL/ (3KR) T.D.: 4490 PBTD: 4456	Anhydrite Depth: 1010 *
Condition of Well: X Good Poor Junk in Hole Casing Leak at:	(Stone Correl Formation)
Proposed Method of Plugging (attach a separate page if additional space is needed):	(Interval)
Sand back to 4250' & cement top of sand	
-	
The Charles Day	- □ N- ?
Is Well Log attached to this application?	ı ∐ wo ·
If ACO-1 not filed, explain why:	
Plugging of this Well will be done in accordance with K.S.A. 55-101 at asg. and the Ru	ules and Regulations of the State Corporation Commission
Company Representative authorized to supervise plugging operations:Melvin_	G Urban (7506
Address: P.O.Box 488 City	Ellinwood, State: KS. zip: 67526
Phone (620) 564-2013 cell 620 793-2712	
Plugging Contractor License #: 31529 Na	me: Kelso Testing & Salvage Inc.
P O Box 467	ress 2:
Cmy:Chase	State: KS . zip: 67524 +
Phone: (620_) 938-2943	•
Proposed Date of Plugging (# known): unknown	
	· ,
Payment of the Plugging Fee (K.A.R. 82-3-118) will be guaranteed by Operator or Age	m
Oate: 3-25-2011 Authorized Operator / Agent Melvin G Urba	an Melsin Bluban RECEIVED

Mail to: KCC - Conservation Division, 130 S. Market - Room 2078, Wichita, Kansas 67202

KANSAS CORPORATION COMMISSION OIL & GAS CONSERVATION DIVISION

Form KSONA-1 July 2010 Form Must Be Typed Form must be Signed All blanks must be Filled

CERTIFICATION OF COMPLIANCE WITH THE KANSAS SURFACE OWNER NOTIFICATION ACT


This form must be submitted with all Forms C-1 (Notice of Intent to Drill); CB-1 (Cathodic Protection Borehole Intent); T-1 (Request for Change of Operator Transfer of Injection or Surface Pit Permit); and CP-1 (Well Plugging Application).

Any such form submitted without an accompanying Form KSONA-1 will be returned.

Select the corresponding form being filed: C-1 (Intent) CB-1 (C	Cathodic Protection Borehole Intent) T-1 (Transfer) X CP-1 (Plugging Application)
OPERATOR: License / 5427	Well Location:
Name: D.R.Lauck Oil Co. Inc.	
Address 1: P.O. Box 488	County: Edwards
Address 2: 110 N Main ST. City: Ellinwood, State: KS. Zip: 67526 +	Lease Name: Mantey Well 4: 3
City: State: Zip: +	If filing a Form T-1 for multiple wells on a lease, enter the legal description of
Contact Person: Melvin G Urban	the lease below:
Phone: (_620_) 5642013 Fax: (_620_) 564_3882	RECEIVED
Email Address:	MAR 2 8 2011
Surface Owner Information:	KCC WICHITA
Name: Roger Grizzell	When filing a Form T-1 involving multiple surface owners, attach an additional sheet listing all of the information to the left for each surface owner. Surface owner information can be found in the records of the register of deeds for the
Address 1: 543 Terrace Drive	
Address 2:	county, and in the real estate property tax records of the county treasurer.
City: Pratt State: KS. zlp: 67124 +	
If this form is being submitted with a Form C-1 (Intent) or CB-1 (Cathodic Protection Borehole Intent), you must supply the surface owners and the KCC with a plat showing the predicted locations of lease roads, tank batteries, pipelines, and electrical lines. The locations shown on the plat are preliminary non-binding estimates. The locations may be entered on the Form C-1 plat, Form CB-1 plat, or a separate plat may be submitted.	
Select one of the following:	
I certify that, pursuant to the Kansas Surface Owner Notice A owner(s) of the land upon which the subject well is or will be lot CP-1 that I am filing in connection with this form; 2) if the form the form; and 3) my operator name, address, phone number, fax, a	ocated: 1) a copy of the Form C-1, Form CB-1, Form T-1, or Form being filed is a Form C-1 or Form CB-1, the plat(s) required by this
I have not provided this information to the surface owner(s). I a KCC will be required to send this information to the surface ow task, I acknowledge that I am being charged a \$30.00 handling	cknowledge that, because I have not provided this information, the wer(s). To mitigate the additional cost of the KCC performing this fee, payable to the KCC, which is enclosed with this form.
If choosing the second option, submit payment of the \$30.00 handling fee with this form. If the fee is not received with this form, the KSONA-1 form and the associated Form C-1, Form CB-1, Form T-1, or Form CP-1 will be returned.	
I hereby certify that the statements made herein are true and correct to the best of my knowledge and belief.	
Date: Mar. 25, 2011 Signature of Operator or Agent: Moh	n B Mbun Title: Production Supt.

BAKER OIL TOOLS, INC.

SERVING THE WORLD

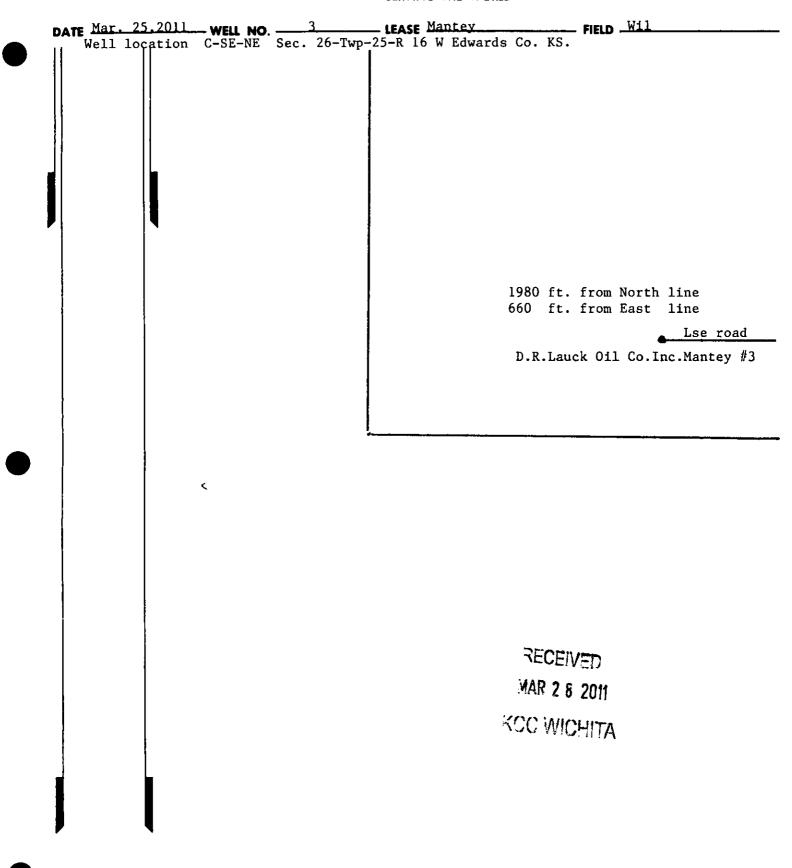









Sam Brownback, Governor, Thomas E. Wright, Chairman Ward Loyd, Commissioner

NOTICE OF RECEIPT OF WELL PLUGGING APPLICATION (CP-1)

D. R. LAUCK OIL CO., INC. 344 S LAURA WICHITA, KS 67211-1517 March 30, 2011

Re: MANTEY #3

API 15-047-00378-00-00

26-25S-16W, 3305 FSL 674 FEL EDWARDS COUNTY, KANSAS

Dear Operator:

This letter is to notify you that the Conservation Division has received your plugging proposal, form CP-1, for the above well and has reviewed the proposal for completeness. The central office will now forward your CP-1 to the district office listed below for review of the proposed plugging method. Please contact the district office for approval of your proposed plugging method at least five (5) days before plugging the well, pursuant to K.A.R. 82-3-113(b). If a workover pit will be used during the plugging of the well it must be permitted. A CDP-1 form must be filed and approved prior to the use of the pit in accordance with K.A.R. 82-3-600.

The Conservation Division's review of form CP-1, either in the central or district office, does not include an inquiry into well ownership or the filing operator's legal right to plug the well. This notice in no way constitutes authorization to plug the above well by persons not having legal rights of ownership or interest in the well.

This notice is void after September 26, 2011. The CP-1 filing does not bring the above well into compliance with K.A.R. 82-3-111 with regard to the Commission's temporary abandonment requirements.

Sincerely,

Steve Bond

Steve Bond

Production Department Supervisor

District: #1
210 E Frontview

210 E Frontview, Suite A Dodge City, KS 67801

(620) 225-8888