


WELL PLUGGING RECORD

Give All Information Completely
Make Required Affidavit
Mail or Deliver Report to:
Conservation Division
State Corporation Commission
800 Bitting Building
Wichita, Kansas

Gove County. Sec. 27 Twp. 13 S Rge. 27 (W)

Location as "NE/CNW $\frac{1}{4}$ /SW $\frac{1}{4}$ " or footage from lines SE SE SE
Lease Owner Skiles Oil Corporation
Lease Name Peirano Well No. 1
Office Address Box 166, Hutchinson, Kansas
Character of Well (completed as Oil, Gas or Dry Hole) dry

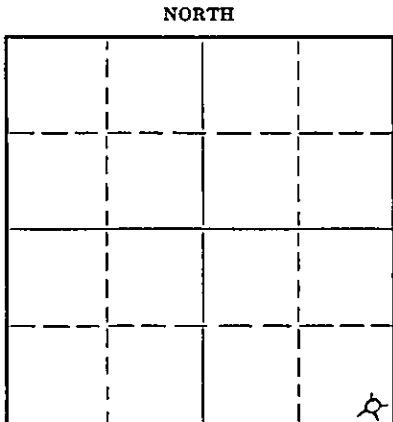

Locate well correctly on above Section Plat

Date well completed April 15, 19 52
Application for plugging filed April 15, 19 52
Application for plugging approved April 16, 19 52
Plugging commenced April 16, 19 52
Plugging completed April 16, 19 52
Reason for abandonment of well or producing formation _____

If a producing well is abandoned, date of last production _____ 19____
Was permission obtained from the Conservation Division or its agents before plugging was commenced? yes
Name of Conservation Agent who supervised plugging of this well Eldon Petty
Producing formation _____ Depth to top _____ Bottom _____ Total Depth of Well 4487 Feet
Show depth and thickness of all water, oil and gas formations.

OIL, GAS OR WATER RECORDS

CASING RECORD

Formation	Content	From	To	Size	Put In	Pulled Out
				<u>10 3/4"</u>	<u>128'</u>	<u>none</u>

Describe in detail the manner in which the well was plugged, indicating where the mud fluid was placed and the method or methods used in introducing it into the hole. If cement or other plugs were used, state the character of same and depth placed, from _____ feet to _____ feet for each plug set.

Pumped hole full of rotary mud. Set bridge in bottom of surface casing and ran 15 sacks cement. Cemented top of surface casing with 10 sacks cement.

RECEIVED
STATE CORPORATION COMMISSION
APR 24 1952
CONSERVATION DIVISION
Wichita, Kansas

(If additional description is necessary, use BACK of this sheet)
Name of Plugging Contractor company
Address _____

STATE OF Kansas, COUNTY OF Reno, ss.
Raymond Gear (employee of owner) or (owner or operator) of the above-described well,

being first duly sworn on oath, says: That I have knowledge of the facts, statements, and matters herein contained and the log of the above-described well as filed and that the same are true and correct. So help me God.

(Signature) Raymond Gear
Box 166, Hutchinson, Kansas
(Address)

SUBSCRIBED AND SWORN to before me this 23 day of April, 19 52

My commission expires November 16, 1953. Wilma A. Clark Notary Public.

PLUGGING 6-51-20M
FILE SEC 27 T 13 R 270
BOOK PAGE 9 LINE 7

15-063-00053-00-00

W E L L L O G

PEIRANO #1

SE SE SE Section 27-13S-27W,
Cove County, Kansas

COMPANY:

SKILES OIL CORPORATION

COMMENCED:

March 28, 1952

COMPLETED:

April 15, 1952

CASING:

10 3/4" set at 128'
100 sacks cement

ELEVATION:

2557 D. F.

FORMATION

DEPTH

Shale	1356
Shale and shells	1910
Shale and lime streaks	2200
Shale and lime	3675
Lime	3740
Shale and lime	3780
Lime	4048
Lime and shale	4175
Lime, cherty	4210
Lime and shaley lime	4275
Shale and lime	4356
Conglomerate	4369
Lime - Mississippi	4487
SCHLIMMERGER	4496

TOPS

Keokuk
Kansas City
Marmaton
Conglomerate
Mississippi lime

PLUGGING
FILE SEC 27T-13R-27W
BOOK PAGE 9 LINE 7

3740
3780
4050
4356
4369
RECEIVED
STATE CORPORATION COMMISSION
APR 24 1952
CONSULTATION DIVISION
Wichita, Kansas

I, Raymond Gear, certify the above to be a true and correct copy of the Driller's Log of the said well, according to the records of this office.

Raymond Gear
District Manager