


STATE OF KANSAS
STATE CORPORATION COMMISSION

Give All Information Completely
Make Required Affidavit
Mail or Deliver Report to:
Conservation Division
State Corporation Commission
211 No. Broadway
Wichita, Kansas

WELL PLUGGING RECORD

Gove County, Sec. 35 Twp. 13S Rge. 27W (EX) (W)
Location as "NE/CNW/SW" or footage from lines C SW NE
Lease Owner D. R. Lauck Oil Company, Inc.
Lease Name Leighton Well No. 1
Office Address 301 S. Broadway, Wichita, Kansas
Character of Well (completed as Oil, Gas or Dry Hole) Dry Hole
Date well completed December 11, 1964
Application for plugging filed December 11, 1964
Application for plugging approved December 11, 1964
Plugging commenced December 11, 1964
Plugging completed December 11, 1964
Reason for abandonment of well or producing formation Dry Hole

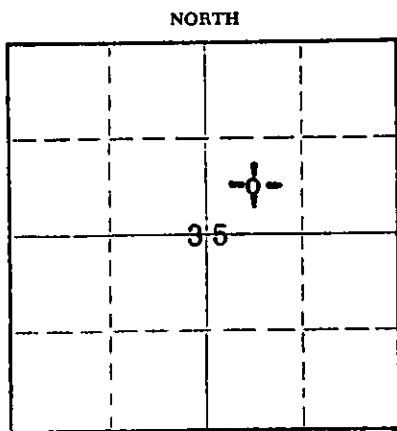

Locate well correctly on above
Section Plat

If a producing well is abandoned, date of last production 19
Was permission obtained from the Conservation Division or its agents before plugging was commenced? Yes

Name of Conservation Agent who supervised plugging of this well W. L. Nichols
Producing formation Depth to top Bottom Total Depth of Well 4553 Feet
Show depth and thickness of all water, oil and gas formations.

OIL, GAS OR WATER RECORDS

CASING RECORD

FORMATION	CONTENT	FROM	TO	SIZE	PUT IN	PULLED OUT
		0'	223'	8-5/8"	223'	None

Describe in detail the manner in which the well was plugged, indicating where the mud fluid was placed and the method or methods used in introducing it into the hole. If cement or other plugs were used, state the character of same and depth placed, from feet to feet for each plug set.

4553'-540' Mud
540'-536' Plug
536'-496' Cement, 20 sacks
496'-210' Mud
210'-206' Plug
206'-166' Cement, 20 sacks
166'- 40' Mud
40'- 36' Plug
36'- 6' Cement, 10 sacks (Bottom of Cellar)

DEC 21 1964
12-21-64
Conservation Division
Wichita, Kansas

(If additional description is necessary, use BACK of this sheet)

Name of Plugging Contractor Sun Cementing Company
Address Great Bend, Kansas

STATE OF KANSAS, COUNTY OF SEDGWICK, SS.
John H. Knightley (employee of owner) or ~~X~~ of the above-described well, being first duly sworn on oath, says: That I have knowledge of the facts, statements, and matters herein contained and the log of the above-described well as filed and that the same are true and correct. So help me God.

(Signature) John H. Knightley
301 S. Broadway, Wichita, Kansas
(Address)

SUBSCRIBED AND SWORN TO before me this 17th day of December, 1964.

My commission expires March 12, 1967.

Stella J. Apps
Notary Public.

15-063-00117-00-00

D. R. Lauck Oil Company, Inc.

Leighton #1

C SW NE Sec. 35-13S-27W
Gove County, Kansas

Commenced: November 27, 1964
Completed: December 11, 1964

Casing Record: 223' 8-5/8" Cemented with 160 sacks Cement,
3 sacks Calcium Chloride.

Elevation: 2615 GL; 2618 DF; 2620 KB.

STATE CORPORATION COMMISSION
DEC 21 1964
CONSERVATION DIVISION
Wichita, Kansas

Drillers Log

Tops

Clay, Shale	223
Shale	830
Sand	865
Shale	1050
Sand	1160
Shale	1415
Shale, Shells w/Sand	
Streaks	1760
Shale, Shells & Red Bed	2096
Anhydrite	2140
Shale & Shells	2430
Shale w/lime streaks	2617
Shale & Lime	2874
Lime & Shale	2970
Lime	3180
Lime & Shale	3250
Lime	3290
Shale & Lime	3460
Lime & Shale	3792
Lime	3930
Lime & Shale	3980
Lime	4067
Lime & Shale	4075
Lime	4121
Lime & Shale	4445
Lime, Shale, Congl.	4465
Lime	4553 RTD

	Sample	Welex
Anhydrite	2096 +524	
Heebner	3805-1185	3808-1188
Toronto		3832-1212
Lansing	3844-1224	3853-1223
Base Kansas City	4137-1517	4138-1518
Pawnee	4242-1622	4249-1229
Ft. Scott	4278-1658	4274-1654
Cherokee	4332-1712	4330-1710=
Mississippian	4437-1817	4438-1818
Total Depth	4553-1933	4553-1933

DST #1 (H) 4007-4067, open 1 hour with strong blow. Recovered 523' muddy salt water and 3' free oil.

ISIP 1342#/30 min.
FSIP 1208#/30 min.
IFP 46#
FFP 278#

DST #2 (H) 4075-4121, open 1 hour with weak blow 13 minutes. Recovered 10' mud.

ISIP 801#/30 min.
FSIP 442#/30 min.
IFP 50#
FFP 50#

DST #3 (H) 4439-4485, open 1 hour with strong blow. Recovered 1550' salt water.

ISIP 1207#/30 min.
FSIP 1088#/30 min.
IFP 397#
FFP 743#

I hereby certify that this is a true and correct log of the above described well, to the best of my knowledge and belief.

John H. Briggley
Sub. Comm. Sec. 35-13S-27W, Gove Co., Kan.
17th of December, 1964
Stella J. Lipp
Notary Public

D&A

My commission expires 3-12-67