


STATE OF KANSAS  
STATE CORPORATION COMMISSION

15-063-00042-00-00

WELL PLUGGING RECORD

Give All Information Completely  
Make Required Affidavit  
Mail or Deliver Report to:  
Conservation Division  
State Corporation Commission  
800 Bittling Building  
Wichita, Kansas

Gove County, Sec. 18 Twp. 13S Rge. 27 (E) (W)

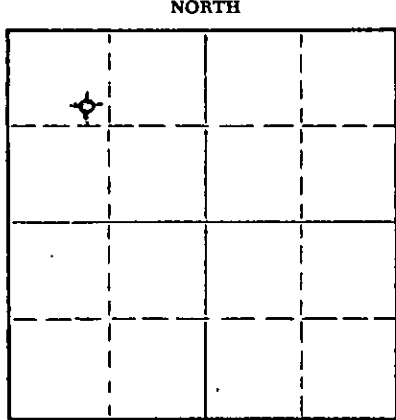

Location as "NE/CNWKSWK" or footage from lines SE-177-1-111  
Lease Owner Guy F. Atkinson Company  
Lease Name Glen Albin Well No. #1  
Office Address Box 176, Republican City, Nebraska  
Character of Well (completed as Oil, Gas or Dry Hole) Dry Hole  
Date well completed 18 September 19 57  
Application for plugging filed 18 September 19 57  
Application for plugging approved 18 September 19 57  
Plugging commenced 18 September 19 57  
Plugging completed 10:00 p.m. 18 September 19 57  
Reason for abandonment of well or producing formation Dry

Locate well correctly on above Section Plat

If a producing well is abandoned, date of last production 19  
Was permission obtained from the Conservation Division or its agents before plugging was commenced? Yes

Name of Conservation Agent who supervised plugging of this well Eldon Petty, Box 326, Hays, Kansas  
Producing formation \_\_\_\_\_ Depth to top \_\_\_\_\_ Bottom \_\_\_\_\_ Total Depth of Well 4360 Feet  
Show depth and thickness of all water, oil and gas formations.

OIL, GAS OR WATER RECORDS

CASING RECORD

FORMATION	CONTENT	FROM	TO	SIZE	PUT IN	PULLED OUT

Describe in detail the manner in which the well was plugged, indicating where the mud fluid was placed and the method or methods used in introducing it into the hole. If cement or other plugs were used, state the character of same and depth placed, from 1360 feet to 140' feet for each plug set.

Set a plug at depth 140'; placed 50% of cotton seed hulls on top of plug; and mixed and placed 20 sacks of regular Portland Cement; then filled the hole with mud up to 140 feet of the ground surface and set another plug; then placed 50% of cotton seed hulls on top of plug; and then mixed and placed 10 sacks of regular Portland Cement to 2' of ground surface.

(If additional description is necessary, use BACK of this sheet)  
Name of Plugging Contractor Golden Cat Drilling Company  
Address Box 775 Wakeeney, Kansas

STATE OF Nebraska, COUNTY OF Harlan, ss.  
James D. Bishop (employee of owner) or (~~owner or operator~~) of the above-described well, being first duly sworn on oath, says: That I have knowledge of the facts, statements, and matters herein contained and the log of the above-described well as filed and that the same are true and correct. So help me God.

(Signature) James D. Bishop  
P. O. Box 176, Republican City, Nebr.  
(Address)

SUBSCRIBED AND SWORN TO before me this 21 day of Sept, 19 57  
Harlan Bishop  
Notary Public.

My commission expires September 4, 1958  
STATE CO.

SEP 23 1957  
CONSERVATION DIVISION  
Wichita, Kansas

PLUGGING  
FILE SEC. 10 T 13 R 27W  
BOOK PAGE 47 L 45

# GOLDEN CAT DRILLING

a n d

15-063-00042-00-00

## SERVICING COMPANY

Office Phone 379

Residence Phone 350

P. O. Box 611

To Kansas Well Log Bureau  
508 East Murdock  
Wichita, Kansas

Well Glen Albin #1 (SE NW NW) Sec. 18 Tw. 13 R. 27W Co. Gove

Commenced: 8-30-57

Completed: 9-18-57

Total Depth: 4360'

Elevation: 2526' RB

Set 152' 8 5/8" surface pipe

0	to	152'	Sand and shale
152'		800	Shale and sand
800		865	Sand
865		1405	Sand, shale and pyrite
1405		1485	Redbed
1485		1530	False anhydrite
1530		1900	Shale, shells and sand
1900		1992	Redbed and sand
1992		2034	Anhydrite
2034		2365	Shale and shells
2365		2453	Shale and salt
2453		2565	Shale and lime streaks
2565		2728	Lime, chert and shale
2728		2742	Sand and shale
2742		3076	Lime and shale
3076		3377	Lime and shale
3377		3516	Lime
3516		3623	Lime and shale
3623		3705	Chert and lime
3705		3860	Lime
3860		3952	Lime
3952		4125	Lime and shale
4125		4210	Lime, chert and shale
4210		4255	Lime
4255		4275	Cherty lime
4275		4360	Lime and chert

4360 TD

**RECEIVED**  
 STATE BOARD OF GEOLOGICAL SURVEY

OCT 3 - 1957

GEOLOGICAL DIVISION  
 Wichita, Kansas

*W. E. Wickizer*  
 W. E. Wickizer

### PLUGGING

FILE SEC. 18 T. 13 R. 27W  
 BOOK PAGE 47 LINE 45

