

Give All Information Completely
Make Required Affidavit
Mail or Deliver Report to:
Conservation Division
State Corporation Commission
211 No. Broadway
Wichita, Kansas

WELL PLUGGING RECORD

Gove County, Sec. 8 Twp. 13S Rge. 27E (E) (W)

Location as "NE/CNW/SW" or footage from lines C NW SE

Lease Owner Mull Drilling Co. Inc.

Lease Name Wakefield Well No. 1

Office Address 1625 Plaza Bldg. Wichita, Kansas

Character of Well (completed as Oil, Gas or Dry Hole) Dry hole.

Date well completed 6-2-63 19

Application for plugging filed 6-2-63 19

Application for plugging approved 6-2-63 19

Plugging commenced 8:00 P.M. 6-2-63 19


Plugging completed 9:15 P.M. 6-2-63 19

Reason for abandonment of well or producing formation

Non productive.

If a producing well is abandoned, date of last production 19

Was permission obtained from the Conservation Division or its agents before plugging was commenced? Yes

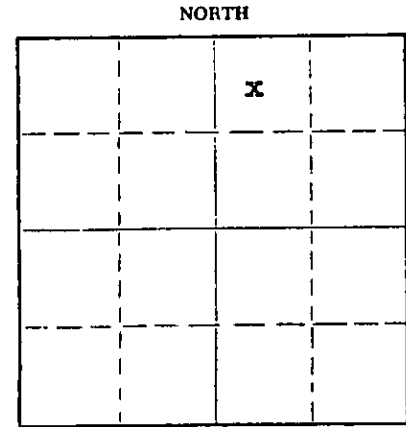

Locate well correctly on above Section Plat

Name of Conservation Agent who supervised plugging of this well E. Nichols, Moreland, Kansas

Producing formation Depth to top Bottom Total Depth of Well 4379' Feet

Show depth and thickness of all water, oil and gas formations.

OIL, GAS OR WATER RECORDS

CASING RECORD

FORMATION	CONTENT	FROM	TO	SIZE	PUT IN	PULLED OUT

Describe in detail the manner in which the well was plugged, indicating where the mud fluid was placed and the method or methods used in introducing it into the hole. If cement or other plugs were used, state the character of same and depth placed, from feet to feet for each plug set.

Plugged through drill pipe with a plug put at 540' with 20 sacks cement, a plug put at 130' with 20 sacks cement and a plug put at 40' with 10 sacks cement.

STATE CORPORATION COMMISSION

JUN 6 1963

CONSERVATION DIVISION

(If additional description is necessary, use BACK of this sheet)

Name of Plugging Contractor Co. tools.

Address Same as above.

STATE OF KANSAS, COUNTY OF SEDGWICK, ss.

Joseph O. Butts (employee of owner) or (owner or operator) of the above-described well, being first duly sworn on oath, says: That I have knowledge of the facts, statements, and matters herein contained and the log of the above-described well as filed and that the same are true and correct. So help me God.

(Signature) Joseph O. Butts
Wichita, Kansas (Address)

SUBSCRIBED AND SWORN TO before me this 5th day of June, 1963

Bertis H. Salter

My commission expires October 16, 1965

Notary Public.



ROTARY DRILLERS' LOG

COMPANY: Mull Drilling Co., Inc. ROTARY DRILLING COMMENCED: 5-24-63
 Wichita, Kansas
 CONTRACTOR: Mull Drilling Co., Inc. ROTARY DRILLING COMPLETED: 6-2-63
 Wichita, Kansas
 CASING RECORD: Set 137' of 8 5/8" surf. LOCATION: Wakefield #1
 csg. w/100 sk. C NW SE of S-13S-27W
 Cove County, Kansas

(Figures indicate bottom of formation - measurements from top of Rotary
 Eaching.)

35'	Surface sand, etc.
154'	Blue shale
900'	Shale
1900'	Shale & Clay
2000'	Shale & sand
2090'	Anhydrite
2240'	Shale, etc.
3084'	Shale & Lime
3213'	Sandy shale w/Lime
4008'	Lime w/shale
4080'	Lime
4192'	Lime w/shale
4351'	Lime
4379'	Mississippi and total depth

RECEIVED
 STATE CORPORATION COMMISSION

JUN 6 1963

CONSERVATION DIVISION
 Wichita, Kansas

I hereby certify that this is a true and correct copy of the
 above log to the best of my knowledge.

MULL DRILLING COMPANY, INC.

Joseph D. Steward, Jr.
 JOSEPH D. STEWARD, JR.

STATE OF KANSAS)
 COUNTY OF SEDGWICK) SS

Subscribed and sworn before me this 5th day of June, 1963.

Lola L. Foster

Lola L. Foster, Notary Public

My commission expires April 17, 1966.

