


Give All Information Completely
Make Required Affidavit
Mail or Deliver Report to:
Conservation Division
State Corporation Commission
211 No. Broadway
Wichita, Kansas

WELL PLUGGING RECORD

NORTH

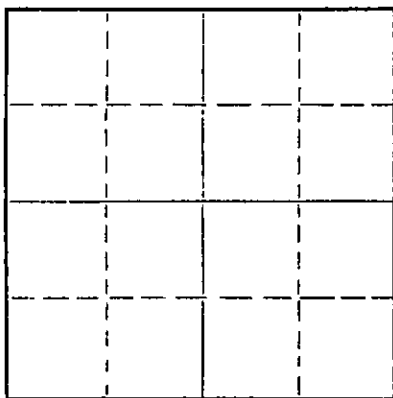

Locate well correctly on above
Section Plat

Gove County. Sec. 1 Twp. 13S Rge. (X) 27 (W)

Location as "NE/CNW&SW&" or footage from lines C NE NE

Lease Owner Rains & Williamson Oil Co.

Lease Name PORTER Well No. 1

Office Address 412 Union Center - Wichita, Kansas

Character of Well (completed as Oil, Gas or Dry Hole) Dry Hole

Date well completed 6-14 19 63

Application for plugging filed 6-14 19 63

Application for plugging approved 6-14 19 63

Plugging commenced 6-14 19 63

Plugging completed 6-14 19 63

Reason for abandonment of well or producing formation No oil or gas found in commercial quantities

If a producing well is abandoned, date of last production ----- 19 --

Was permission obtained from the Conservation Division or its agents before plugging was commenced? Yes

Name of Conservation Agent who supervised plugging of this well Bill Nichols, Moreland, Kansas

Producing formation None Depth to top --- Bottom --- Total Depth of Well 4540 Feet

Show depth and thickness of all water, oil and gas formations.

OIL, GAS OR WATER RECORDS

CASING RECORD

FORMATION	CONTENT	FROM	TO	SIZE	PUT IN	PULLED OUT
				8-5/8"	185'	NONE

Describe in detail the manner in which the well was plugged, indicating where the mud fluid was placed and the method or methods used in introducing it into the hole. If cement or other plugs were used, state the character of same and depth placed, from _____ feet to _____ feet for each plug set.

Filled hole with rotary mud to 600'. Set first plug at 600' and cemented through drill pipe with 20 sacks cement. Filled hole with rotary mud to 180'. Set second plug at 180' and cemented through drill pipe with 20 sacks of cement. Filled hole with rotary mud to 35' of base of cellar and capped with hulls and 10 sacks of cement. Plugging completed at 9:30 A.M., June 14, 1963.

STATE CORPORATION COMMISSION

JUN 18 1963

CONSERVATION DIVISION
Wichita, Kansas

(If additional description is necessary, use BACK of this sheet)
Name of Plugging Contractor Rains & Williamson Oil Co.
Address 412 Union Center - Wichita, Kansas

STATE OF KANSAS, COUNTY OF SEDGWICK, ss.
Wilson Rains - Partner (owner or operator) of the above-described

well, being first duly sworn on oath, says: That I have knowledge of the facts, statements, and matters herein contained and the log of the above-described well as filed and that the same are true and correct. So help me God.

(Signature) Wilson Rains Wilson Rains
412 Union Center - Wichita, Kansas
(Address)

SUBSCRIBED AND SWORN TO before me this 17th day of June 19 63

My commission expires November 8, 1966 Sherry Gish Notary Public.

INVOICED
DATE 6/18/63
INV. NO. 10128

ROTARY DRILLING LOG

OPERATOR: Rains & Williamson Oil Co.
 #1 PORTER
 C NE NE Section 1-13S-27W
 Gove County, Kansas

CONTRACTOR: Rains & Williamson
 Oil Co.
 COMMENCED: 6-2-63
 COMPLETED: 6-14-63

Remarks: Set 8-5/8" casing at
 185', cemented with
 120 sacks quick cement

Formations

Surface Clay	20'
Sand	40'
Shale	80'
Sand	110'
Shale	185'
Blue Shale	300'
Shale	970'
Shale and Sand	1100'
Sand	1180'
Shale and Red Bed	1538'
Anhydrite	1550'
Shale and shells	2195'
Anhydrite	2240'
Shale and Shells	2675'
Lime and Shale	3110'
Shale and Lime	3290'
Lime and Shale	3450'
Shale and Lime	3630'
Lime and Shale	3935'
Lime	4480'
Lime, Shale and Chert	4520'
Lime	4540'
Rotary Total Depth (D & A)	4540'

RECEIVED
 STATE CORPORATION COMMISSION

JUN 18 1963


CONSERVATION DIVISION
 Wichita, Kansas

We certify the above log is true
 and correct to the best of our
 knowledge and belief.

RAINS & WILLIAMSON OIL CO.


 Wilson Rains
 Partner

Subscribed and sworn to before me, a
 Notary Public within and for the State
 of Kansas, County of Sedgwick, this
 12th day of June, 1963.

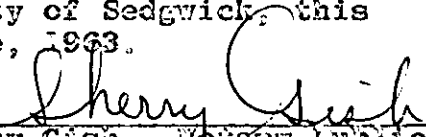
 Sherry Gish Notary Public

My Commission Expires: November 8, 1966