

RECEIVED  
STATE CORPORATION COMMISSION  
FORM CP-4


FEB 25 1982  
02-25-82  
CONSERVATION DIVISION  
Wichita, Kansas

STATE OF KANSAS  
STATE CORPORATION COMMISSION

WELL PLUGGING RECORD

Give All Information Completely  
Make Required Affidavit  
Mail or Deliver Report to  
Conservation Division  
State Corporation Comm.  
245 North Water  
Wichita, KS 67202

Hamilton County, Sec. 20 Twp. 22 Rge. 39  $\frac{1}{4}$ / $\frac{1}{4}$   
Location as "NE/CNW $\frac{1}{4}$ SW $\frac{1}{4}$ " or footage from lines  
C-SW  $\frac{1}{4}$   
Lease Owner Osborn Heirs Co.  
Lease Name Kerr Well No. #1  
Office Address Box 17968, San Antonio, TX 78286  
Character of Well (Completed as Oil, Gas or Dry Hole)  
Gas  
Date Well completed 19  
Application for plugging filed 10-8-81 19  
Application for plugging approved 19  
Plugging commenced 1-5-82 19  
Plugging completed 1-5-82 19  
Reason for abandonment of well or producing formation  
Non Commercial Value  
If a producing well is abandoned, date of last production  
None 19  
Was permission obtained from the Conservation Division or  
its agents before plugging was commenced? yes

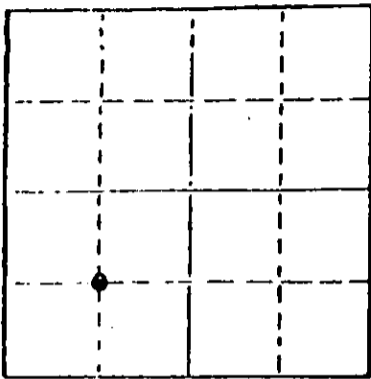

Locate well correctly on above  
Section Plot

Name of Conservation Agent who supervised plugging of this well Mr. Thomas  
Producing formation Hugoton Depth to top 2686 Bottom 2714 Total Depth of Well 2770  
Show depth and thickness of all water, oil and gas formations.

OIL, GAS OR WATER RECORDS

CASING RECORD

| FORMATION  | CONTENT | FROM | TO | SIZE   | PUT IN | PULLED OUT |
|------------|---------|------|----|--------|--------|------------|
| Surface    |         |      |    | 8 5/8" | 320'   | 0'         |
| Production |         |      |    | 5 1/2" | 2767'  | 0'         |

Describe in detail the manner in which the well was plugged, indicating where the mud fluid was placed and the method or methods used in introducing it into the hold. If cement or other plugs were used, state the character of same and depth placed, from feet to feet for each plug set.

Pumped 25 sks. cement & 2 sks. hulls to 2520'  
Displaced w/mud to 400'  
Pumped 25 sks. cement 400' to 250'  
Displaced w/mud to 50'  
Put Bridge & 10 sks. cement 50' to 0'  
Cut off 8 5/8" & 5 1/2", 3' below ground level

(If additional description is necessary, use BACK of this sheet)

Name of Plugging Contractor Midwest Casing Pulling Service  
Permit #766

STATE OF KANSAS COUNTY OF Haskell, ss.  
I, Edgar J. Eves (Notary Public) or (owner or operator)  
of the above-described well, being first duly sworn on oath, says: That I have knowledge of the facts, statements, and matters herein contained and the log of the above-described well as filed and that the same are true and correct. So help me God.

(Signature) Edgar J. Eves  
Box F, Sublette, Ks. 67877  
(Address)

SUBSCRIBED AND SWORN TO before me this 6th day of Jan., 1982

Sandra L. Eves  
Notary Public.

My commission expires 12-6-84

