


15-063 - 00048-00-00

WELL PLUGGING RECORD

Give All Information Completely  
Make Required Affidavit  
Mail or Deliver Report to:  
Conservation Division  
State Corporation Commission  
800 Bitting Building  
Wichita, Kansas

Loc. Gove County. Sec. 11 Twp 13 Rge. 30 ~~28~~ (W)

NORTH

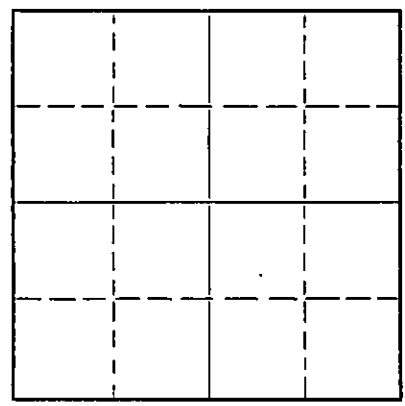

Locate well correctly on above Section Plat

Location as "NE/CNW $\frac{1}{4}$ SW $\frac{1}{4}$ " or footage from lines \_\_\_\_\_  
 Lease Owner Musgrove Petroleum Corporation  
 Lease Name Losey Well No. 1  
 Office Address 407 KFH Building, Wichita 2, Kansas  
 Character of Well (completed as Oil, Gas or Dry Hole) Dry Hole  
 Date well completed October 2 19 51  
 Application for plugging filed October 2 19 51  
 Application for plugging approved October 2 19 51  
 Plugging commenced October 2 19 51  
 Plugging completed October 7 19 51  
 Reason for abandonment of well or producing formation Dry

If a producing well is abandoned, date of last production None 19 \_\_\_\_\_  
 Was permission obtained from the Conservation Division or its agents before plugging was commenced? Yes

Name of Conservation Agent who supervised plugging of this well Unknown  
 Producing formation \_\_\_\_\_ Depth to top \_\_\_\_\_ Bottom \_\_\_\_\_ Total Depth of Well 4730 Feet  
 Show depth and thickness of all water, oil and gas formations.

OIL, GAS OR WATER RECORDS

CASING RECORD

Formation	Content	From	To	Size	Put In	Pulled Out
				8-5/8"	210'	Cemented

Describe in detail the manner in which the well was plugged, indicating where the mud fluid was placed and the method or methods used in introducing it into the hole. If cement or other plugs were used, state the character of same and depth placed, from \_\_\_\_\_ feet to \_\_\_\_\_ feet for each plug set.

Filled hole with heavy mud to 200 feet  
Set first slug @ 200 feet  
Put in 1/2 Sack hulls and 15 Sacks Cement  
Set second slug at 40 feet  
Put in 1/2 sack hulls and 10 Sacks Cement

(If additional description is necessary, use BACK of this sheet)

Name of Plugging Contractor Musgrove Petroleum Corporation  
 Address 407 KFH Building  
Wichita 2, Kansas

STATE OF Kansas, COUNTY OF Sedgwick, ss.  
Gordon L. Koelling (employee of owner) or (owner or operator) of the above-described well,  
 being first duly sworn on oath, says: That I have knowledge of the facts, statements, and matters herein contained and the log of the above-described well as filed and that the same are true and correct. So help me God.

(Signature) Gordon L. Koelling  
407 KFH Building (Address)

SUBSCRIBED AND SWORN to before me this 22nd day of October, 1951

My commission expires August 31, 1955 Ada C. May Notary Public.

FILE 11 T 13 R 30W  
 BOOK PAGE 114 LINE 15

10-23-1951

15-0103-00048-00-00

**CONTRACTOR'S WELL LOG**

**COMPANY:** Mangrove Petroleum Corporation  
**CONTRACTOR:** Mangrove Petroleum Corporation  
**FAH#:** Lesty #1  
**LOCATION:** SE SE SW Section 11-13S-30W  
 Gove County, Kansas  
**COMMENCED:** September 12, 1951  
**COMPLETED:** October 4, 1951

0	60	Sand
60	210	Green shale
210	375	Shale
375	910	Shale & shells
910	1200	Shale
1200	1550	Green shale
1550	1730	Sand
1730	1750	Sand & shale
1750	1850	Shale & shells
1850	2065	Shale
2065	2265	Shale & red bed
2265	2345	Shale
2345	3260	Shale & lime streaks
3260	3300	Shale & lime
3300	3731	Lime
3731	4520	Lime & shale
4320	4464	Lime
4464	4498	Lime & chert
4498	4510	Lime
4510	4548	Cherty lime
4548	4566	Lime & chert
4566	4573	Cherty lime
4573	4603	Lime
4603	4730	TD (Rotary)

Set 210' of 8-5/8" surface casing, cemented with 150 sacks.  
D & A

STATE OF KANSAS }  
COUNTY OF SEDWICK } SR:

I GORDON L. KUELLEN, do hereby certify that the above and foregoing is a true and correct copy of the log of Lesty #1, Section 11-13-30W, Gove County, Kansas, as reflected by files of the Mangrove Petroleum Corporation.

MANGROVE PETROLEUM CORP.

By: *Gordon L. Kullen*  
Secretary-Treasurer

Subscribed and sworn to before me a Notary Public, within and for Sedwick County, Kansas this 17th day of October, 1951.

My commission expires: August 31, 1955. Ada C. May  
Notary Public

**PLUGGING**  
FILE SEC 11 T 13 1101  
BOOK PAGE 114 LINE 15  
10-23-1951