


15-063-20317-00-00

STATE OF KANSAS
STATE CORPORATION COMMISSION

Form CP-4

WELL PLUGGING RECORD

Give All Information Completely
Make Required Affidavit
Mail or Deliver Report to:
Conservation Division
State Corporation Commission
P. O. Box 17027
Wichita, Kansas 67217
NORTH

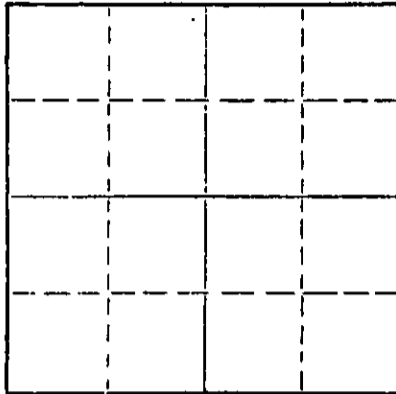

Locate well correctly on above
Section Plat

Gove County, Sec. 29 Twp. 13S Rge. (E) 30 (W)
Location as "NE/CNWxSWx" or footage from lines C SE NW
Lease Owner Chief Drilling Co., Inc. & Bill J. Porter
Lease Name Ottley Well No. #1
Office Address 905 Century Plaza, Wichita, Kansas 67202
Character of Well (completed as Oil, Gas or Dry Hole) Dry Hole
Date well completed 12/18/76 19
Application for plugging filed 12/20/76 19
Application for plugging approved 12/18/76 19
Plugging commenced 12/18/76 19
Plugging completed 12/18/76 19
Reason for abandonment of well or producing formation Dry Hole

If a producing well is abandoned, date of last production _____ 19____
Was permission obtained from the Conservation Division or its agents before plugging was commenced? Yes

Name of Conservation Agent who supervised plugging of this well Gilbert Baltzor, Palco, Kansas
Producing formation _____ Depth to top _____ Bottom _____ Total Depth of Well 4532 Feet
Show depth and thickness of all water, oil and gas formations.

OIL, GAS OR WATER RECORDS

CASING RECORD

FORMATION	CONTENT	FROM	TO	SIZE	PUT IN	PULLED OUT
		0	289'	8 5/8"		

Describe in detail the manner in which the well was plugged, indicating where the mud fluid was placed and the method or methods used in introducing it into the hole. If cement or other plugs were used, state the character of same and depth placed, from _____ feet to _____ feet for each plug set.

Plugged through drill pipe @ 1100' w/70 sx. cement
Plugged through drill pipe @ 300' w/20 sx. cement
Plugged through drill pipe @ 40' w/10 sx. cement

12-27-1976

(If additional description is necessary, use BACK of this sheet)

Name of Plugging Contractor Chief Drilling Co., Inc.
Address 905 Century Plaza, Wichita, Kansas 67202

STATE OF KANSAS, COUNTY OF SEDGWICK, ss.
Jim Robinson (employee of owner) or (owner or operator) of the above-described well, being first duly sworn on oath, says: That I have knowledge of the facts, statements, and matters herein contained and the log of the above-described well as filed and that the same are true and correct. So help me God.

(Signature) Jim Robinson
905 Century Plaza, Wichita, Kansas 67202
(Address)

SUBSCRIBED AND SWORN TO before me this 20th day of December, 1976

My commission expires _____

Marilyn Sinaud
Marilyn Sinaud Notary Public.

WELL LOG

15-063-20317-00-00

CHIEF DRILLING CO., INC.
905 Century Plaza
Wichita, Kansas 67202

#1 Ottley
C SE NW Sec. 29-13S-30W
Gove County, Kansas

CONTRACTOR: Chief Drilling Co., Inc. & Bill Porter
CASING RECORD: 8 5/8" set @ 289' w/175 sx.

COMMENCED: 12/8/76
COMPLETED: 12/18/76

<u>FORMATION</u>	<u>FROM</u>	<u>TO</u>	<u>ELEVATIONS</u>
Surface Mud & Clay	0	660	2802 Gr.
Shale	660	3940	2804 D.F.
Shale & Lime	3940	4090	2807 K.B.
Lime	4090	4491	
Lime & Shale	4491	4532	
RTD	4532		

<u>FORMATION TOPS</u>	
Anhydrite	2272 + 535
Base Anhydrite	2304 + 503
Heebner	3847 - 1040
Toronto	3872 - 1065
Lansing	3890 - 1083
Base K.C.	4206 - 1399
Marmaton	4239 - 1432
Ft. Scott	4390 - 1583
Lower Cher. Shale	4418 - 1611
Base Cher.	4480 - 1673
Rewk. Miss.	4486 - 1679
Miss.	4502 - 1695
LTD	4532 - 1725

DEC 27 1976
12-27-1976

STATE OF KANSAS, COUNTY OF SEDGWICK) ss:

I hereby certify that the above is a true and correct copy of the Driller's Log of the well drilled in the C SE NW of Section 29-13S-30W, Gove County, Kansas, to the best of my knowledge and belief.

CHIEF DRILLING CO., INC.

Jim Robinson
Jim Robinson, Vice-President

Subscribed and sworn to before me this 20th day of December, 1976.

Marilyn Sinard
Marilyn Sinard Notary Public