


STATE OF KANSAS
STATE CORPORATION COMMISSION

Give All Information Completely
Make Required Affidavit
Mail or Deliver Report to:
Conservation Division
State Corporation Commission
211 No. Broadway
Wichita, Kansas

WELL PLUGGING RECORD

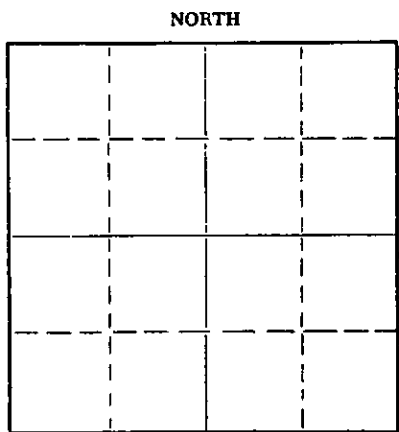

Ellis County, Sec. 4 Twp. 13S Rge. 16 (E) 16 (W)
Location as "NE/CNWxSWx" or footage from lines C SE SE NW
Lease Owner Cooperative Refinery Ass'n.
Lease Name Kline Well No. 1
Office Address Box 765 Great Bend, Kansas
Character of Well (completed as Oil, Gas or Dry Hole) Dry hole
Date well completed Nov. 7 19 60
Application for plugging filed Verbal 19
Application for plugging approved yes 19
Plugging commenced Nov. 7 19 60
Plugging completed Nov. 7 19 60
Reason for abandonment of well or producing formation Dry hole
If a producing well is abandoned, date of last production 19
Was permission obtained from the Conservation Division or its agents before plugging was commenced? yes

Name of Conservation Agent who supervised plugging of this well Eldon Petty
Producing formation _____ Depth to top _____ Bottom _____ Total Depth of Well 3420 Feet
Show depth and thickness of all water, oil and gas formations.

OIL, GAS OR WATER RECORDS

15-051-04768-00-00

CASING RECORD

FORMATION	CONTENT	FROM	TO	SIZE	PUT IN	PULLED OUT
				8 5/8	76	-0-

Describe in detail the manner in which the well was plugged, indicating where the mud fluid was placed and the method or methods used in introducing it into the hole. If cement or other plugs were used, state the character of same and depth placed, from _____ feet to _____ feet for each plug set.

Set bottom plug at 500' with 20 sc. cement through drill pipe, 2nd plug at 180' with 15 sx. cement through drill pipe, top plug and heavy mud to 40', 1/2 sx. hulls and 10 sc. cement. Complete

11-14-60

Name of Plugging Contractor Shields Drlg. Company
Address Russell, Ks.

STATE OF KANSAS, COUNTY OF BARTON, ss.
Marvin Sullivan (employee of owner) or (owner or operator) of the above-described well, being first duly sworn on oath, says: That I have knowledge of the facts, statements, and matters herein contained and the log of the above-described well as filed and that the same are true and correct. So help me God.

(Signature) Marvin Sullivan
Box 765 Gt. Bend, Ks.
(Address)

SUBSCRIBED AND SWORN TO before me this 10 day of November, 19 60

Notary Public

My commission expires October 15, 1963

DRILLERS LOG

Kline #1

Elevation: 2003 D.F.

Loc: C SE SE NW
 Sec: 4-13S-16W
 Ellis County, Kansas
 Operator: Cooperative Refinery Ass'n.
 Contractor: Shields Drlg. Company

Casing: 8 5/8" @ 76' w/
 75 sx.
 Comm: 10-31-60 Comp: 11-7-60
 Total Depth: 3420'.

----- 15.051.04768.00.00 -----

<u>From</u>	<u>To</u>	<u>Formation</u>
0	97	Surface hole
97	900	Shale, shells, sand
900	1145	Shale, shells, redbed
1145	1185	Anhydrite
1185	1625	Shale and shells
1625	1880	Shale with lime
1880	2015	Lime with shale streaks
2015	2225	Lime and shale
2225	2410	Lime
2410	2735	Shale with lime
2735	3029	Lime and shale
3029	3085	Lime
3085	3135	Lime with shale
3135	3420	Lime
3420		R.T.D.

(STATE OF KANSAS)
 (COUNTY OF BARTON)

NOV 14 1960
 CONSERVATION DIVISION
 Wichita, Kansas

I hereby certify that the above is a true and correct copy of the log on the Kline #1 well, located C SE SE NW of Section 4-13S-16W, Ellis County, Kansas

Martin Sullivan

Subscribed and sworn to before me this 10 day of November 1960.

Lotha Jo Smith

My commission expires: October 15, 1963