


STATE OF KANSAS
STATE CORPORATION COMMISSION

Give All Information Completely
Make Required Affidavit
Mail or Deliver Report to:
Conservation Division
State Corporation Commission
212 North Market, Insurance Bldg.
Wichita, Kansas

15-051-06692-00-01
WELL PLUGGING RECORD

NORTH

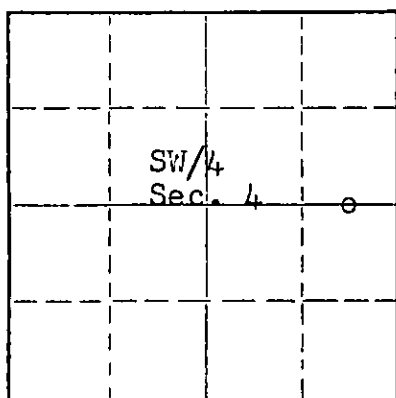

Locate well correctly on above
Section Plat

Ellis County. Sec. 4 Twp 13 Rge. 16 ~~RE~~ (W)
Location as "NE/CNW/SW" or footage from lines C E/2-E/2 SW.
Lease Owner CRA INC.
Lease Name Madden Well No. 1
Office Address Drawer C Great Bend, Kansas 67530
Character of Well (completed as Oil, Gas or Dry Hole) Abandoned Injection Well
Date well completed 4-3- 19 61
Application for plugging filed July 22 19 66
Application for plugging approved July 22 (Verbal) 19 66
Plugging commenced July 22 19 66
Plugging completed July 23 19 66
Reason for abandonment of well or producing formation Deteriorated Casing.

If a producing well is abandoned, date of last production Injection Well 19
Was permission obtained from the Conservation Division or its agents before plugging was com-
menced? Yes, Verbal by Mr. Leo Massey

Name of Conservation Agent who supervised plugging of this well Leo Massey
Producing formation ----- Depth to top ----- Bottom ----- Total Depth of Well 3,300 Feet
Show depth and thickness of all water, oil and gas formations.

OIL, GAS OR WATER RECORDS

CASING RECORD

FORMATION	CONTENT	FROM	TO	SIZE	PUT IN	PULLED OUT
L-KC	Injection	3211	3260	8-5/8"	187'	None
				2-7/8"	3,268'	None

Describe in detail the manner in which the well was plugged, indicating where the mud fluid was placed and the method or methods used
in introducing it into the hole. If cement or other plugs were used, state the character of same and depth placed, from ----- feet to
----- feet for each plug set.

Loaded 2-7/8" casing with heavy mud and circulated.
Spotted 35 sacks cement thru 1" tubg. to 588'. Shut
in 1-1/2 hours. Spotted 20 sacks cement, Down 2-7/8"
casing to surface. Casing cut off below plow depth.

07-29-66

(If additional description is necessary, use BACK of this sheet)

Name of Plugging Contractor Top Drilling Company (Globe Cementing Company)
Address Great Bend, Kansas

STATE OF Kansas, COUNTY OF Barton, ss.
J.D. Alcott (employee of owner) ~~not owner or operator~~ of the above-described

well, being first duly sworn on oath, says: That I have knowledge of the facts, statements, and matters herein contained and the log of the
above-described well as filed and that the same are true and correct. So help me God.

(Signature)

Drawer C Great Bend, Kansas 67530
(Address)

SUBSCRIBED AND SWORN TO before me this 27th day of July, 1966

My commission expires August 19, 1968

Ruth Pound, Notary Public.

DRILLERS' LOG

15-051-06692-00-01

Well Owner: Spencer Drilling, Inc.
Farm Name: M. S. Maddon Well No. 1
Total Depth: 3530'
Commenced: 3/25/61
Completed: 4/3/61
Casing: 8 5/8" @ 167' com.
Tubing: 2 1/2" @ 3268' com.
Contractor: PEEL BROTHERS, INC.

NE SE SW
Sec. 4, Twp. 13S, Rge. 16W
Ellis County,
Kansas
Elevation:
Production:

Figures below indicate bottoms of formations:

Surface clay & shale	0 -	167
Shale & Shells		590
Sand Streaks		690
Shale & shells		1110
Anhydrite		1145
Shale & shells		1820
Lime		2210
Lime & shale		2530
Shale		2590
Lime shells & shale		2654
Shale & lime		2920
Lime		2995
Lime & shale		3160
Lime		3163
Shale		3167
Lime		3481
Lime & chert		3580
Total Depth		3580

This is to certify that the above information is to the best of our knowledge, true and correct.

PEEL BROTHERS, INC.

By James M. Talt

SUBSCRIBED AND SWORN to before me this 6 day of April, 1961

My commission expires: April 27, 1964

Luck Brant
Notary Public

RECEIVED
KANSAS CORPORATION COMMISSION

AUG 2 1965

CONSERVATION DIVISION
Wichita, Kansas