

STATE OF KANSAS
STATE CORPORATION COMMISSION

WELL PLUGGING RECORD

Give All Information Completely
Make Required Affidavit
Mail or Deliver Report to:
Conservation Division
State Corporation Commission
211 No. Broadway
Wichita, Kansas

Finney County, Sec. 31 Twp. 26S Rge. 34W (E) (W)

Location as "NE/CNW/SW" or footage from lines 40' S 55' E C SW SE

Lease Owner White Eagle Oil Company

Lease Name U. S. A. "A" Well No. 8

Office Address Box 255; Garden City, Kansas

Character of Well (completed as Oil, Gas or Dry Hole) Junked Hole

Date well completed _____ 19____

Application for plugging filed 4-14 1959

Application for plugging approved 4-14 1959

Plugging commenced 4-15 1959


Plugging completed 4-17 1959

Reason for abandonment of well or producing formation Lost hole due to junk.

lost 16 jts. 5 1/2" csg. Unable to fish out.

If a producing well is abandoned, date of last production _____ 19____

Was permission obtained from the Conservation Division or its agents before plugging was commenced? Yes

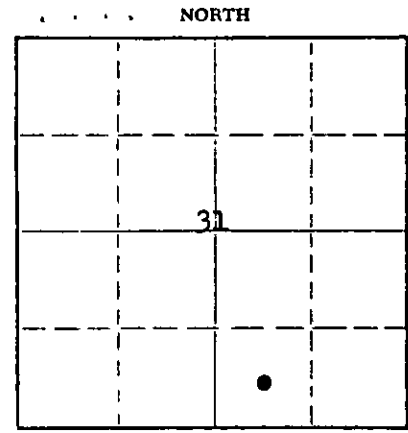

Locate well correctly on above Section Plat

Name of Conservation Agent who supervised plugging of this well Merle A. Rives

Producing formation NONE Depth to top _____ Bottom _____ Total Depth of Well 5157 Feet

Show depth and thickness of all water, oil and gas formations.

OIL, GAS OR WATER RECORDS

CASING RECORD

FORMATION	CONTENT	FROM	TO	SIZE	PUT IN	PULLED OUT
				8 5/8"	799'	NONE

Describe in detail the manner in which the well was plugged, indicating where the mud fluid was placed and the method or methods used in introducing it into the hole. If cement or other plugs were used, state the character of same and depth placed, from _____ feet to _____ feet for each plug set.

Filled hole with 40 Viscosity mud. Spotted plug through drill pipe by Halliburton as follows:

500 sacks cement 1920' to 1847'

20 sacks cement 600' to 540'

10 sacks cement 35' to bottom of cellar

RECORDED
STATE CORPORATION COMMISSION

APR 22 1959

CONSERVA
Wichita

(If additional description is necessary, use BACK of this sheet)

Name of Plugging Contractor Helmerich & Payne

Address Liberal, Kansas

STATE OF Kansas, COUNTY OF Finney, ss.

T. E. Mort (employee of owner) or (owner or operator) of the above-described well, being first duly sworn on oath, says: That I have knowledge of the facts, statements, and matters herein contained and the log of the above-described well as filed and that the same are true and correct. So help me God.

(Signature) T. E. Mort

Box 255; Garden City, Kansas
(Address)

SUBSCRIBED AND SWORN TO before me this 20th day of April 19 59

Russell Welch

Notary Public.

My commission expires 11-29-60

PLUGGING
FILE SEC. 31 T. 26 R. 34W
BOOK PAGE 33 LI. E. 2

U.S.A. "A"-8
 White Eagle Oil Company
 Section 31-26S-34W
Finney County, Kansas

CASING RECORD:

COMMENCED: 3-16-59

26 Jts. 8-5/8" Csg. @ 799' w/400 sxs. Common & 100 sxs. Pozmix;
 27 CG

Plugged well. Skidded rig 115' West and 75" North and spudded
 another U.S.A. "A"-8 Unit well.

	<u>FROM</u>	<u>TO</u>
Red Bed & Shells	0	1002
Red Bed & Shale	1002	2193
Shale & Shells	2193	2440
Shale	2440	2704
Shale & Shells	2704	2840
Shale	2840	2952
Shale & Lime	2952	3135
Lime	3135	3227
Lime & Shale	3227	3705
Shale	3705	3890
Lime	3890	3986
Shale & Lime	3986	4120
Lime & Shale	4120	4265
Lime	4265	4275
Lime & Shale	4275	4428
Lime	4428	4456
Lime & Shale	4456	4878
Lime	4878	4915
Lime & Shale	4915	5010
Shale & Lime	5010	5055
No Returns	5055	5157

RECEIVED
 STATE CORPORATION DEPARTMENT

MAY 8 1959

CONSERVATION DIVISION
 Wichita, Kansas

STATE OF OKLAHOMA)
) SS
 County of Tulsa)

I hereby affirm that the above and foregoing is a true and correct copy of the log of
 the U.S.A. "A"-8 well, located in Section 31-26S-34W, Finney County, Kansas.

HELMRICH & PAYNE

Harry Saye
 Vice President

Subscribed and sworn to before me a Notary Public this 4th day of May, 1959.

Margaret Bailey
 Notary Public

My commission expires:

3-30-60

PLUGGING
 FILE SEC 31 T26 R34W
 BOOK PAGE 33 LINE 9