


STATE OF KANSAS
STATE CORPORATION COMMISSION

Give All Information Completely
Make Required Affidavit
Mail or Deliver Report to:
Conservation Division
State Corporation Commission
800 Bitting Building
Wichita, Kansas

15-063-00051-00-00

WELL PLUGGING RECORD

NORTH

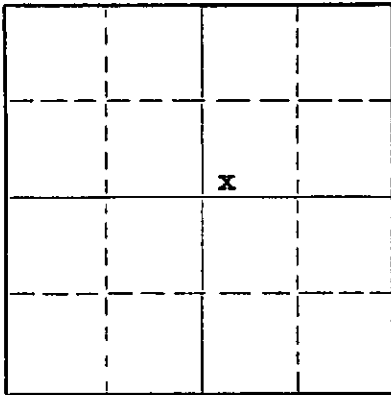

Locate well correctly on above
Section Plat

GOVE County. Sec. 16 Twp. 13 Rge. 28 (E) W (W)

Location as "NE/CNW&SW" or footage from lines SW/4 SW/4 NE/4

Lease Owner Prime Drilling Company & Davis Bros.

Lease Name Mendenhall Well No. 1

Office Address 1516 Liberty Bank Bldg., Okla. City, Okla.

Character of Well (completed as Oil, Gas or Dry Hole) Dry Hole

Date well completed 7-12-1952

Application for plugging filed 7-12-1952

Application for plugging approved 7-12-1952

Plugging commenced 7-12-1952

Plugging completed 7-12-1952

Reason for abandonment of well or producing formation

If a producing well is abandoned, date of last production 19

Was permission obtained from the Conservation Division or its agents before plugging was commenced? Yes

Name of Conservation Agent who supervised plugging of this well Eldon Petty

Producing formation Depth to top Bottom Total Depth of Well 4550 Feet

Show depth and thickness of all water, oil and gas formations.

OIL, GAS OR WATER RECORDS

CASING RECORD

FORMATION	CONTENT	FROM	TO	SIZE	PUT IN	PULLED OUT
				8-5/8	204	None

Describe in detail the manner in which the well was plugged, indicating where the mud fluid was placed and the method or methods used in introducing it into the hole. If cement or other plugs were used, state the character of same and depth placed, from feet to feet for each plug set.

Filled hole with heavy drilling mud to 190' set plug and cemented with 15 sacks cement. Filled hole with heavy drilling mud to 40' set plug and cemented to bottom of cellar with 10 sacks cement.

RECEIVED
STATE CORPORATION COMMISSION

JUL 17 1952 07-17-52

CONSERVATION DIVISION
Wichita, Kansas

(If additional description is necessary, use BACK of this sheet)

Name of Plugging Contractor Prime Drilling Company

Address 1516 Liberty Bank Bldg., Oklahoma City, Oklahoma

STATE OF Oklahoma, COUNTY OF Oklahoma, ss.

L. J. Kruse (employee of owner) or (Notary Public) of the above-described well, being first duly sworn on oath, says: That I have knowledge of the facts, statements, and matters herein contained and the log of the above-described well as filed and that the same are true and correct. So help me God.

(Signature) *L. J. Kruse*

Oklahoma City, Oklahoma (Address)

SUBSCRIBED AND SWORN TO before me this 15th day of July, 1952

Lillian Wright
Notary Public.

My commission expires October 24, 1955

24-2875-S 2-52-20M

PLUGGING
FILE NO. 16 T 13 R 28
BOOK PAGE 30 LINE 34

15-063-00051-00-00

PRIME DRILLING COMPANY & DAVIS BROS.

SW/4 SW/4 NE/4 Section 16-13S-28W,
GOVE COUNTY, KANSAS

MENDENHALL # 1 WELL

<u>FORMATION</u>	<u>FROM</u>	<u>TO</u>	<u>REMARKS</u>
Shale	0	55	
Sand & Shale	55	110	
Shale	110	120	8-5/8" C.S.A. set @ 204'.
Shale	120	400	Cemented with 150 sacks.
Shale & Shells	400	500	
Gray Shale	500	700	
Gray Shale	700	770	
Shale & Shell	770	920	
Sand & Shale	920	1060	
Shale & Shell	1060	1240	
Sand	1240	1340	
Shale & Shells	1340	1390	
Red Bed Shale & Shells	1390	2085	
Anhydrite	2085	2120	
Red Bed Shale & Shell	2120	2240	
Shale & Lime	2240	3630	
Lime & Shale	3630	3790	
Lime	3790	4060	
Lime & Shale	4060	4370	
Lime & Shale Chert	4370	4455	
Lime & Chert	4455	4525	
Lime Shale Chert	4525	4550	
Total Depth		4550'	

I hereby certify the foregoing to be a true and accurate Driller's Log of the formations encountered in the above well.

PRIME DRILLING COMPANY

By: L. J. Kruse
L. J. Kruse

Subscribed and sworn to before me this 16th day of July, 1952.

William Wright
Notary Public

My Commission Expires October 24, 1955
STATE CORPORATION COMMISSION

RECEIVED
JUL 17 1952
CONSERVATION DIVISION
Wichita, Kansas

PLUGGING
FILE SEC 16-13S-28W
BOOK PAGE 30 LINE 34