

15-063-00022-00-00

WELL PLUGGING RECORD

STATE OF KANSAS
STATE CORPORATION COMMISSION


Give All Information Completely
Make Required Affidavit
Mail or Deliver Report to:
Conservation Division
State Corporation Commission
800 Bitting Building
Wichita, Kansas

FORMATION PLUGGING RECORD

Strike out upper line
when reporting plug-
ging off formations.

Gove County, Sec. 13 Twp. 13S Rge. 28 (E) W (W)

Location as "NE1/4NW1/4SW1/4" or footage from lines NE1/4 NE1/4 NE1/4
Lease Owner Texon Oil and Land Company
Lease Name T. L. Smith Estate Well No. 1
Office Address Drawer 1267, Ponca City, Oklahoma
Character of Well (completed as Oil, Gas or Dry Hole) Dry hole
Date well completed January 1, 19 44
Application for plugging filed January 2, 19 44
Application for plugging approved January 2, 19 44
Plugging commenced January 4, 19 44
Plugging completed January 4, 19 44
Reason for abandonment of well or producing formation Dry Hole

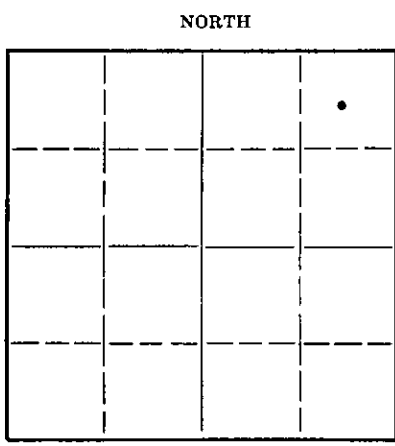

Locate well correctly on above
Section Flat

If a producing well is abandoned, date of last production No production 19...
Was permission obtained from the Conservation Division or its agents before plugging was com-
menced? Yes

Name of Conservation Agent who supervised plugging of this well L. R. C. Alexander, Great Bend, Kansas
Producing formation Oolitic Lime Depth to top 4621' Bottom 4642' Total Depth of Well 4642' Feet

Show depth and thickness of all water, oil and gas formations.

OIL, GAS OR WATER RECORDS

CASING RECORD

Formation	Content	From	To	Size	Put In	Pulled Out
				13-3/8"	195'1"	None

Describe in detail the manner in which the well was plugged, indicating where the mud fluid was placed and the method or methods used in introducing it into the hold. If cement or other plugs were used, state the character of same and depth placed, from...feet to...feet for each plug set.

The hole was filled with heavy mud to within 195' of the top where a wood plug was set and cemented with 20 sacks of cement; the hole was then filled with heavy mud to within 15' of the top where a wood plug was set and capped with 15 sacks of cement.

01-23-44

13 13 28W
104 19

(If additional description is necessary, use BACK of this sheet)

Correspondence regarding this well should be addressed to Texon Oil and Land Company
Address R. F. D. #4, Lyons, Kansas

STATE OF Kansas, COUNTY OF Rice, ss.
F. L. Dunn (employee of owner) or (owner or operator) of the above-described well,

being first duly sworn on oath, says: That I have knowledge of the facts, statements, and matters herein contained and the log of the above-described well as filed and that the same are true and correct. So help me God.

(Signature) F. L. Dunn

R. F. D. #4, Lyons, Kansas (Address)

SUBSCRIBED AND SWORN to before me this 20th day of January, 1944

Quinn McShine Notary Public

My commission expires October 21st, 1944

15-063-00022-0000

W E L L R E C O R D

T. L. Smith Estate Well No. 1

Date Spudded: Nov. 14, 1943
Drig. Completed: January 1, 1944
Date Plugged: January 4, 1944

Loc: 330' South & 330' West of NE
corner of Sec. 13, Twp. 13S, Rge.
28E, Cove County, Kansas

FROM	TO	FORMATION	FROM	TO	FORMATION
0	45	Surface soil	2095	2209	Shale & shells
45	69	Sand	2209	2225	Shale
69	200	Shale	2225	2603	Shale & shells
200	205	Broken lime	2603	2654	Shale
205	300	Shale	2654	2728	Anhydrite & shale
300	375	Chalk	2728	2790	Sandy lime
375	525	Shale	2790	3177	Lime
525	651	Shale & shells	3177	3217	Shale & shells
651	800	Shale	3217	3310	Broken lime
800	825	Lime	3310	3343	Lime
825	1195	Sand & shale	3343	3412	Broken lime
1195	1300	Shale & sand	3412	3453	Lime
1300	1470	Shale & shells	3453	3475	Broken lime
1470	1510	Anhydrite	3475	4202	Lime
1510	1600	Shale & shells	4202	4243	Broken lime
1600	1780	Red Sed	4243	4349	Lime
1780	2005	Shale & shells	4349	4390	Sandy lime
2005	2095	Anhydrite	4390	4645	Lime

Elevation 2527'

Ran 195'1" of 13-3/8" 48; ST Lapweld casing; set at 195'; cemented with 250 sacks of cement.

Top of Mississippi lime 4297' - no show of oil.

Top of Arbuckle Lime 4536' - no show of oil.

Top of Colitic lime 4621' - no show of oil.

Total depth prior to plugging 4642' in Colitic lime.

Plugged and abandoned January 4, 1944.

Note: All above footages calculated from ground level, except formations.

I, the undersigned, being first duly sworn upon oath, state that this Well Record is true, correct and complete according to the records of this office, and to the best of my knowledge and belief.

E. L. Quinn District Superintendent

Subscribed and sworn to before me this 30th day of January, 1944.

Lewis McHenry Public

My Commission Expires October 21st, 1944.

FLD-RL
1-20-44
LPC (3)
TMC
Corp. Comm.
File

13 13 28W
104 19