


WELL PLUGGING RECORD

Give All Information Completely
Make Required Affidavit
Mail or Deliver Report to:
Conservation Division
State Corporation Commission
311 No. Broadway
Wichita, Kansas

Gove County, Sec. 23 Twp. 13 Rge. 28 (E) W (W)

Location as "NE/CNWKSWK" or footage from lines C NE SW
Lease Owner G. L. Miles
Lease Name Roberts Well No. 1
Office Address /Box 339, Great Bend, Kansas
Character of Well (completed as Oil, Gas or Dry Hole) Dry
Date well completed 10/18/1965
Application for plugging filed 10/18/1965
Application for plugging approved 10/18/1965
Plugging commenced 10/19/1965
Plugging completed 10/19/1965
Reason for abandonment of well or producing formation _____

NORTH

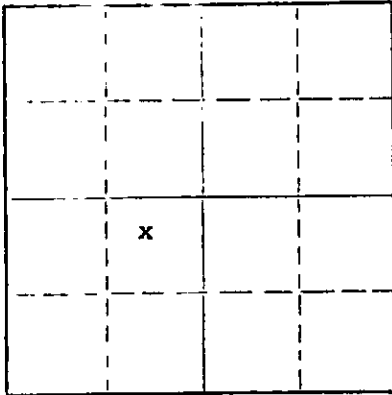

Locate well correctly on above
Section Plat

If a producing well is abandoned, date of last production _____ 19____
Was permission obtained from the Conservation Division or its agents before plugging was commenced? Yes

Name of Conservation Agent who supervised plugging of this well Eldon Petty
Producing formation _____ Depth to top _____ Bottom _____ Total Depth of Well 4530 Feet
Show depth and thickness of all water, oil and gas formations.

OIL, GAS OR WATER RECORDS

CASING RECORD

FORMATION	CONTENT	FROM	TO	SIZE	PUT IN	PULLED OUT
				8 5/8	135'	-0-

Describe in detail the manner in which the well was plugged, indicating where the mud fluid was placed and the method or methods used in introducing it into the hole. If cement or other plugs were used, state the character of same and depth placed, from _____ feet to _____ feet for each plug set.

Filled hole with heavy mud to 600'. Set plug with 1/4 sack hulls on top of plug and 20 sacks cement on top of plug through drill pipe.
Filled hold to 180' with heavy mud. Set plug with 1/4 sack hulls on top of plug and 20 sacks cement on top of plug through drill pipe.
Filled hole to 40' and set plug and 8 sacks cement on top of plug and put 2 sacks cement in rat hole.

(If additional description is necessary, use BACK of this sheet)

Name of Plugging Contractor Miles Drilling Company
Address Box 339, Great Bend, Kansas

STATE OF Kansas COUNTY OF Barton, ss.
Harold M. Boyd, Tool pusher (employee of owner) or (owner or operator) of the above-described well, being first duly sworn on oath, says: That I have knowledge of the facts, statements, and matters herein contained and the log of the above-described well as filed and that the same are true and correct. So help me God.

(Signature) Harold M Boyd
Box 339, Great Bend, Kansas
(Address)

SUBSCRIBED AND SWORN to before me this 20th day of October, 1965

My commission expires 5/9/67
Kata Boyd Notary Public.

MILES DRILLING COMPANY
P. O. BOX 339
GREAT BEND KANSAS, 67530

WELL LOG
ROBERTS
#1
C NE SW Sec 23-13S-28W
Gove County Kansas

TO	FROM	
40	135	Sand and shale
135	600	Sand, shale and clay
600	1195	Shale
1195	1565	Dakota sand and shale
1565	1630	Shale and sand
1630	1981	Red bed and shale
1981	2015	Anhydrite
2015	2215	Shale
2215	2223	Anhydrite
2223	2860	Shell and shale
2860	3253	Shale and lime
3253	3370	Lime
3370	3720	Lime and shale
3720	4255	Lime
4255	4300	Lime and shale
4300	4410	Lime
4410	4488	Lime and shale
4488	4515	Lime w/chert
4515	4530	Lime
4530	TD	Total depth

State of Kansas
County of Barton

Harold M. Boyd, Tool-pusher for Miles Drilling company, being first duly sworn on oath says: that I have knowledge of the facts, statements and matters herein contained and the log of the above described well as filed and that the same are true and correct.

Harold M Boyd
Harold M. Boyd

Reata L Boyd
Reata L. Boyd, Notary Public
Barton County, Kansas

My Commission expires
5/9/67