


STATE OF KANSAS
STATE CORPORATION COMMISSION

WELL PLUGGING RECORD

Give All Information Completely
Make Required Affidavit
Mail or Deliver Report to:
Conservation Division
State Corporation Commission
211 No. Broadway
Wichita, Kansas

GOVE County. Sec. 35 Twp. 13S Rge. (E) 28 (W)

NORTH

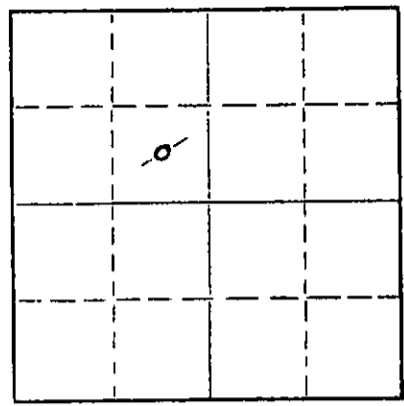

Locate well correctly on above
Section Plat

Location as "NE/CNWxSWx" or footage from lines C SE NW
Lease Owner Gulf Oil Corporation
Lease Name CRIST Well No. 1
Office Address 316 Union Center Bldg., Wichita, Kansas 67202
Character of Well (completed as Oil, Gas or Dry Hole) DRY HOLE
Date well completed 2-11 19 65
Application for plugging filed 2-12 19 65
Application for plugging approved Verbally 2-11 19 65
Plugging commenced 2-11 19 65
Plugging completed 2-11 19 65
Reason for abandonment of well or producing formation DRY HOLE

If a producing well is abandoned, date of last production - 19
Was permission obtained from the Conservation Division or its agents before plugging was commenced? Yes

Name of Conservation Agent who supervised plugging of this well Mr. W. L. Nichols
Producing formation - Depth to top Bottom Total Depth of Well 4500 Feet
Show depth and thickness of all water, oil and gas formations.

OIL, GAS OR WATER RECORDS

CASING RECORD

FORMATION	CONTENT	FROM	TO	SIZE	PUT IN	PULLED OUT
				8-5/8"	218'	NONE

Describe in detail the manner in which the well was plugged, indicating where the mud fluid was placed and the method or methods used in introducing it into the hole. If cement or other plugs were used, state the character of same and depth placed, from feet to feet for each plug set.

P&A as follows: Cmt Plug at 540' w/20 sx Cl "A" thru DP, Cmt Pg at 210' w/20 sx Cl "A" through DP, cmt plug at surface w/10 sx Cl "A" through DP.

FEB 16
08-16-65

(If additional description is necessary, use BACK of this sheet)
Name of Plugging Contractor Red Tiger Drilling Company
Address 1720 Wichita Plaza Building, Wichita, Kansas 67202

STATE OF KANSAS, COUNTY OF SEDGWICK, ss.
G. V. KERSTEN (employee of owner) or (owner/operating) of the above-described well, being first duly sworn on oath, says: That I have knowledge of the facts, statements, and matters herein contained and the log of the above-described well as filed and that the same are true and correct. So help me God.

(Signature) G. V. Kersten
316 Union Center Bldg., Wichita, Kansas 67202
(Address)

SUBSCRIBED AND SWORN TO before me this 12th day of FEBRUARY, 1965

My commission expires June 3, 1965

C. C. LEWIS, NOTARY PUBLIC Notary Public.

DRILLERS LOG

No. 1 Crist

CASING RECORD: 8 5/8" @ 230' w/175 sx cement
 COMPANY: Gulf Oil Corporation
 CONTRACTOR: Red Tiger Drilling Co.
 COMMENCED: January 31, 1965
 COMPLETED: February 11, 1965
 DESCRIPTION: SE NW 35-135-28W
 Gove Co., Kansas
 ELEVATION: 2617 DF
 2620 RB
 TOTAL DEPTH: 4500'

<u>FORMATION</u>	<u>FROM</u>	<u>TO</u>	<u>REMARKS</u>
Surface soil & Sand	0	50	
Shale & Shells	50	231	
Shale	231	1561	
Blane Anhydrite	1561	1590	
Redrock & Shale	1590	1631	
Shale	1631	1680	
Sand	1680	1845	
Shale & Shells	1845	2075	
Anhydrite	2075	2115	
Shale & Shells	2115	2200	
Shale	2200	2545	
Lime & Shale	2545	2771	
Lime	2771	3070	
Lime & Shale	3070	3815	
Lime	3815	4175	
Chalk Shale & Lime	4175	4240	
Lime & Shale	4240	4294	
Lime	4294	4435	
Mississippi	4435	4500	

RECEIVED
 STATE CORPORATION COMMISSION
 FEB 26 1965
 CONSERVATION DIVISION
 Wichita, Kansas

I certify that this is a true and correct copy of the above log to the best of my knowledge.

RED TIGER DRILLING COMPANY

Maxine V. Head
 Maxine V. Head

Subscribed and sworn to before me this 19th day of February, 1965.

Dean Keller
 Notary Public

My Commission Expires:
5-22-68