

15-063-20236-00-00

FORM CP-4

STATE OF KANSAS
STATE CORPORATION COMMISSION
CONSERVATION DIVISION
P. O. BOX 17027
WICHITA, KANSAS 67217

WELL PLUGGING RECORD

Gove County, Sec. 6 Twp. 13S Rge. (E) 30 (W)

Location as "NE/CNWSW" or footage from lines NW NE

Lease Owner Abercrombie Drilling, Inc

Lease Name SHAW Well No. #1

Office Address 801 Union Center, Wichita, Ks. 67202

Character of Well (completed as Oil, Gas or Dry Hole) Dry Hole

Date well completed May 5 19 75

Application for plugging filed (verbal) May 5 19 75

Application for plugging approved (verbal) May 5 19 75

Plugging commenced May 5 19 75

Plugging completed May 5 19 75

Reason for abandonment of well or producing formation No commercial quantity of oil encountered

If a producing well is abandoned, date of last production 19

Was permission obtained from the Conservation Division or its agents before plugging was commenced? Yes (verbally)

Name of Conservation Agent who supervised plugging of this well Gilbert Balthazor

Producing formation Depth to top Bottom Total Depth of Well 4130

Show depth and thickness of all water, oil and gas formations.

OIL, GAS OR WATER RECORDS

CASING RECORD

FORMATION	CONTENT	FROM	TO	SIZE	PUT IN	PULLED OUT
				8-5/8"	198.56'	None

Describe in detail the manner in which the well was plugged, indicating where the mud fluid was placed and the method or methods used in introducing it into the hole. If cement or other plugs were used, state the character of same and depth placed, from feet to feet for each plug set.

1st Plug Set @ 1300' with 70 sx. cement

2nd Plug Set @ 200' with 40 sx. cement

3rd Plug Set @ 40' with 10 sx. cement

(If additional description is necessary, use BACK of this sheet)

Name of Plugging Contractor Abercrombie Drilling, Inc.

Address 801 Union Center, Wichita, Kansas 67202

STATE OF KANSAS COUNTY OF SEDGWICK ss.

Jerry A. Langrehr, Exec. V.P. (employee of owner) or (owner or operator) of the above-described

well, being first duly sworn on oath, says: That I have knowledge of the facts, statements, and matters herein contained and the log of the above-described well as filed and that the same are true and correct. So help me, God.

(Signature) Jerry A. Langrehr

801 Union Center, Wichita, Ks. 67202

(Address)

Sworn to before me this 9th day of May 19 75

Nancy E. Haas Notary Public.

April 8, 1978



OS-12-1975

KANSAS DRILLERS LOG

KANSAS GEOLOGICAL SURVEY
 Kans. Geo. Survey request
 samples on this well.

S. 6 T. 13 R. 30 ^E _W

API No. 15 — 063 — 20,236-00-00
 County Number

Loc. NW NE

County Gove

Operator
Abercrombie Drilling, Inc.

Address
801 Union Center Wichita, Kansas 67202


Well No. #1 Lease Name Shaw

Footage Location
1980 feet from (N) XX line 1980 feet from (E) XX line

Principal Contractor Abercrombie Drilling, Inc. Geologist Harold L. Steincamp

Spud Date April 22, 1975 Total Depth 4630' P.B.T.D.

Date Completed May 5, 1975 Oil Purchaser None - Dry Hole

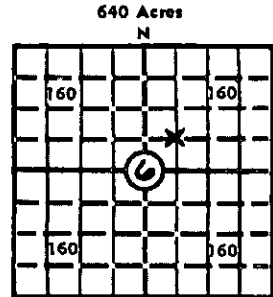

Elev.: Gr. 2899'

DF 2902' KB 2904'

CASING RECORD

Report of all strings set — surface, intermediate, production, etc.

Purpose of string	Size hole drilled	Size casing set (in O.D.)	Weight lbs./ft.	Setting depth	Type cement	Sacks	Type and percent additives
Surface	12 3/4"	8-5/8"		206.56'	Sunset	165	None

LINER RECORD

PERFORATION RECORD

Top, ft.	Bottom, ft.	Sacks cement	Shots per ft.	Size & type	Depth interval

TUBING RECORD

Size	Setting depth	Packer set at

ACID, FRACTURE, SHOT, CEMENT SQUEEZE RECORD

Amount and kind of material used	Depth interval treated

05-12-1975

INITIAL PRODUCTION

Date of first production		Producing method (flowing, pumping, gas lift, etc.)			
RATE OF PRODUCTION PER 24 HOURS	Oil	Gas	Water	Gas-oil ratio	
	bbls.	MCF	bbls.	CFPB	
Disposition of gas (vented, used on lease or sold)			Producing interval(s)		

INSTRUCTIONS: As provided in KCC Rule 82-2-125, within 90 days after completion of a well, one completed copy of this Drillers Log shall be transmitted to the State Geological Survey of Kansas, 4150 Monroe Street, Wichita, Kansas 67209. Copies of this form are available from the Conservation Division, State Corporation Commission, 3830 So. Meridian (P.O. Box 17027), Wichita, Kansas 66217. Phone AC 316-522-2206. If confidential custody is desired, please note Rule 82-2-125. Drillers Logs will be on open file in the Oil and Gas Division, State Geological Survey of Kansas, Lawrence, Kansas 66044.

Operator **Abercrombie Drilling, Inc.** DESIGNATE TYPE OF COMP.: OIL, GAS, DRY HOLE, SWDW, ETC.:

Well No. **#1** Lease Name **SHAW** Dry Hole

S 6 T 13S R 30 ^X/_W

WELL LOG


Show all important zones of porosity and contents thereof; corad intervals, and all drill-stem tests, including depth interval tested, cushion used, time tool open, flowing and shut-in pressures, and recoveries.

SHOW GEOLOGICAL MARKERS, LOGS RUN, OR OTHER DESCRIPTIVE INFORMATION.

FORMATION DESCRIPTION, CONTENTS, ETC.	TOP	BOTTOM	NAME	DEPTH
Surface Dirt & Sand	0	150	<u>ELECTRIC LOG TOPS:</u>	
Shale	150	2376		
Anhydrite	2376	2409	Heebner	3929
Shale	2409	2720	Toronto	3958
Lime & Shale	2720	2945	Lansing	3978
Lime	2945	3280	B/Kansas City	4264
Lime & Shale	3280	3770	Marmaton	4295
Lime	3770	4630	Fort Scott	4419
Rotary Total Depth		4630	Cherokee Shale	4440
			Mississippi	4542
			ELTD	4627
DST #1 (3840-3894) 15", 30", 30", 30". Recovered 190' oil spkd mud. IFP 14-35#; IBHP 1210#; FFP 45-111#; FBHP 1152#. 112°.				
DST #2 (3882-3923) 15", 45", 60", 45". Strong blow. Recovered 660' SW. IFP 35-95#; IBHP 1244#; FFP 117-382#; FBHP 1164#. 119°.				
DST #3 (4004-4019) Mis-Run				
DST #4 (3983-4019) 15", 45", 60", 45" Recovered 1140' SW. IFP 35-143#; IBHP 1244#; FFP 167-525#; FBHP 1233#. 115°.				
DST #5 (4054-4136) 15", 45", 30", 30". Weak blow 30". Recovered 15' Mud. FP's 71-71#; IBHP 1314#; FBHP 1187#.				
DST #6 (4128-4201) 15", 45", 30", 30". Weak blow 15". Recovered 10' Oil spotted mud. IFP 47-59#; IBHP 1164#; FFP 59-59#; FBHP 769#. 115°.				
Plugged and Abandoned				

USE ADDITIONAL SHEETS, IF NECESSARY, TO COMPLETE WELL RECORD.

Date Received _____

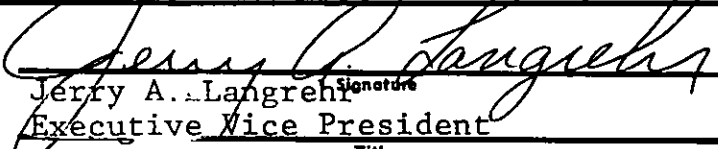
 Jerry A. Langrehr Signature
 Executive Vice President
Title
 May 9, 1975
Date