


STATE OF KANSAS
STATE CORPORATION COMMISSION

WELL PLUGGING RECORD

Give All Information Completely
Make Required Affidavit
Mail or Deliver Report to
Conservation Division
State Corporation Comm.
245 North Water
Wichita, KS 67202

County. Sec. 8 Twp. 13S Rge. 30 E/W
Location as "NE/CNW/SW" or footage from lines

SE NW SE
Lease Owner Zenith Drilling Corporation, Inc.
Lease Name Beougher Well No. #1
Office Address 200 W. Douglas, Wichita, Kansas 67202
Character of Well (Completed as Oil, Gas or Dry Hole)

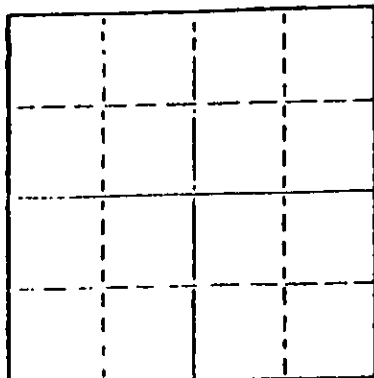

Locate well correctly on above
Section Plat

Dry Hole
Date Well completed 1-12-78 19
Application for plugging filed 1-12-78 19
Application for plugging approved 1-12-78 19
Plugging commenced 1-12-78 19
Plugging completed 1-12-78 19

Reason for abandonment of well or producing formation
Commercial quantities of oil not found
If a producing well is abandoned, date of last production 19

Was permission obtained from the Conservation Division or
its agents before plugging was commenced? Yes

Name of Conservation Agent who supervised plugging of this well Gilbert Balthazor, Palco, Ks.
Producing formation Depth to top Bottom Total Depth of Well 4215'
Show depth and thickness of all water, oil and gas formations.

OIL, GAS OR WATER RECORDS

CASING RECORD

FORMATION	CONTENT	FROM	TO	SIZE	PUT IN	PULLED OUT
				8 5/8"	206'	None

Describe in detail the manner in which the well was plugged, indicating where the mud fluid was placed and the method or methods used in introducing it into the hold. If cement or other plugs were used, state the character of same and depth placed, from feet to feet for each plug set.

Plug @ 1050' w/70 sx.	RECEIVED
Plug @ 200' w/20 sx.	STATE CORPORATION COMMISSION
Plug @ 40' w/10 sx.	
Rat Hole 2 sx.	MAR 03 1978
	03-03-1978
	CONSERVATION DIVISION
	Wichita, Kansas

(If additional description is necessary, use BACK of this sheet)

Name of Plugging Contractor Rains & Williamson Oil Co., Inc.


STATE OF Kansas COUNTY OF Sedgwick, ss.
Wilson Rains, President of Rains & Williamson Oil Co., Inc. (employee of owner) or (owner or operator)
of the above-described well, being first duly sworn on oath; says: That I have knowledge of
the facts, statements, and matters herein contained and the log of the above-described well
as filed and that the same are true and correct. So help me God

(Signature) Wilson Rains
435 Page Court, 220 W. Douglas, Wichita, Ks. 67202
(Address)

AND SWORN TO before me this 17 day of January, 1978

My Commission Expires 10-4-79

Juanita M. Green
Juanita M. Green Notary Public.

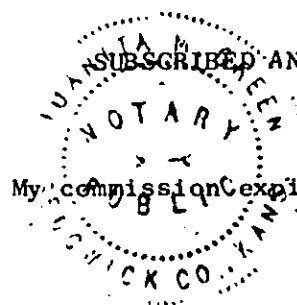

15-063-20367-00-00

DRILLER'S LOG

COMPANY: Zenith Drilling Corporation, Inc. SEC. 8 T. 13S R. 30W

LOC. SE NW SE

WELL NAME: Beougher #1

COUNTY: Gove

RIG NO. #1

TOTAL DEPTH 4215'

ELEVATION

COMMENCED: 1-4-78

COMPLETED: 1-12-78

CONTRACTOR: Rains & Williamson Oil Co., Inc.

CASING RECORD:

SURFACE: 8 5/8" @ 206' w/175 sx. 50/50 poz., 3% cc., 2% gel.

PRODUCTION: D&A

LOG

(Figures Indicate Bottom of Formations)

Sand & Shale	207
Shale	1880
Sand & Lime	2307
Sand & Shale	2402
Shale & Sand	2940
Shale	3420
Sand & Shale	3627
Shale & Sand & Lime	3894
Lime & Shale	4071
Lime	4215
<u>ROTARY TOTAL DEPTH</u>	<u>4215</u>

RECEIVED
STATE CORPORATION COMMISSION

MAR 03 1978
03-03-1978
CONSERVATION DIVISION
Wichita, Kansas

STATE OF Kansas)
COUNTY OF Sedgwick) SS:

I, Wilson Rains, President of Rains & Williamson Oil Co., Inc.
upon oath state that the above and foregoing is a true and correct copy of the log of the
Beougher #1 well.

Wilson Rains
Wilson Rains



Subscribed and sworn to before me this 17 day of January, 1978.

My Appointment Expires:
10-4-79

Juanita M. Green
Juanita M. Green