


STATE OF KANSAS
STATE CORPORATION COMMISSION

WELL PLUGGING RECORD

Give All Information Completely
Make Required Affidavit
Mail or Deliver Report to
Conservation Division
State Corporation Comm.
245 North Water
Wichita, KS 67202

Gove County, Sec. 25 Twp. 13S Rge. 29 E/W
Location as "NE/CNW 1/4 SW 1/4" or footage from lines
C N/2 SE/4

Lease Owner A. Scott Ritchie
Lease Name Goetz "A" Well No. 1
Office Address Suite 950, 125 N. Market Wichita, Ks. 67202
Character of Well (Completed as Oil, Gas or Dry Hole) Dry Hole

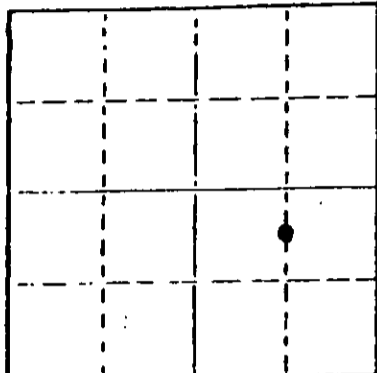

Locate well correctly on above
Section Plot

Date Well completed 10-6-1978
Application for plugging filed 10-6-1978
Application for plugging approved 10-6-1978
Plugging commenced 10-6-1978
Plugging completed 10-6-1978
Reason for abandonment of well or producing formation Dry Hole

If a producing well is abandoned, date of last production 19

Was permission obtained from the Conservation Division or its agents before plugging was commenced? Yes

Name of Conservation Agent who supervised plugging of this well Gilbert Bolthazor
Producing formation _____ Depth to top _____ Bottom _____ Total Depth of Well _____
Show depth and thickness of all water, oil and gas formations.

OIL, GAS OR WATER RECORDS

CASING RECORD

FORMATION	CONTENT	FROM	TO	SIZE	PUT IN	PULLED OUT
Surface Pipe		0	300	8 5/8"	288.78	

Describe in detail the manner in which the well was plugged, indicating where the mud fluid was placed and the method or methods used in introducing it into the hold. If cement or other plugs were used, state the character of same and depth placed, from _____ feet to _____ feet for each plug set.

#1 Plug set @ 1000' with 70 sacks cement

#2 Plug set @ 240' with 20 sacks cement

#3 Plug set @ 40' with 10 sacks cement

RECEIVED
STATE CORPORATION COMMISSION
OCT 12 1978
10-12-78
CONSERVATION DIVISION
Wichita, Kansas

(If additional description is necessary, use BACK of this sheet)

Name of Plugging Contractor Blue Goose Drilling Co., Inc.

STATE OF Kansas COUNTY OF Barton ss.


George E. Miller, Jr. (employee of owner) or (owner or operator) of the above-described

well, being first duly sworn on oath, says: That I have knowledge of the facts, statements, and matters herein contained and the log of the above-described well as filed and that the same are true and correct. So help me God.

(Signature) George E. Miller, Jr.
(Address) _____

Subscribed and sworn to before me this 11th day of October, 1978

8-1-81
Mary Ann Schwabrown
Notary Public.

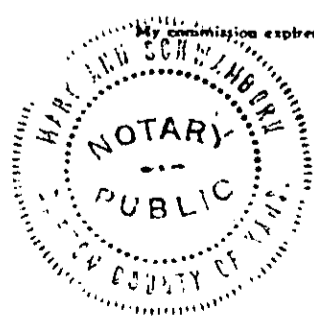

WELL LOG
 Goetz "A"-#1 -
 C N/2 SE/4 25-13S-29W
 Gove County, Kansas

Name of Operator: A. Scott Ritchie
 Suite 950, 125 N. Market
 Wichita, Kansas 67202

Date Completed: October 6, 1978

FROM	TO	
0	300	Surface Soil and sand
300	1094	Sand and shale
1094	1592	Shale and shells
1592	2195	Shale
2195	2222	Anhydrite
2222	2450	Shale
2450	2565	Shale and shells
2565	2765	Shale
2765	2966	Lime and shale
2966	3160	Shale and shells
3160	3451	Shale and lime
3451	3594	Shale and shells
3594	3860	Lime and shale
3860	3908	Lime
3908	3912	Shale and lime
3912	4104	Lime
4104	4185	Shale and lime
4185	4285	Lime
4285	4385	Shale and lime
4385	4500	Lime
4500		Total Depth

RECEIVED
 STATE OF KANSAS
 OCT 12 1978
 CONSERVATION DIVISION
 Wichita, Kansas

STATE OF KANSAS

COUNTY OF BARTON ss

George E. Miller, Jr., President of Blue Goose Drilling Co., Inc.
 being first duly sworn on oath says: That I have knowledge of the facts,
 statements and matters herein contained and the log of the above described well
 as filed and that the same are true and correct.

George E. Miller, Jr.
 George E. Miller, Jr.

Subscribed and sworn before me this 11th day of October, 1978.

Mary Ann Schwabert
 Notary Public Barton County

My Commission Expires 8-1--81.

