

15-063-20549-00-00

STATE OF KANSAS
STATE CORPORATION COMMISSION


Form CP-4

Give All Information Completely
Make Required Affidavit
Mail or Deliver Report to:
Conservation Division
State Corporation Commission
P. O. Box 17027
Wichita, Kansas 67217
NORTH

WELL PLUGGING RECORD

Gove County, Sec. 6 Twp. 13S Rge. (E) 29W (W)

Location as "NE/CNW/SE/SW" or footage from lines C. NW SW
Lease Owner DONALD C. SLAWSON
Lease Name Lewis 'T' Well No. 1
Office Address 200 Douglas Building Wichita, Kansas 67202
Character of Well (completed as Oil, Gas or Dry Hole) Dry Hole
Date well completed December 14, 1981
Application for plugging filed December 14, 1981
Application for plugging approved December 14, 1981
Plugging commenced December 14, 1981
Plugging completed December 14, 1981
Reason for abandonment of well or producing formation Dry Hole

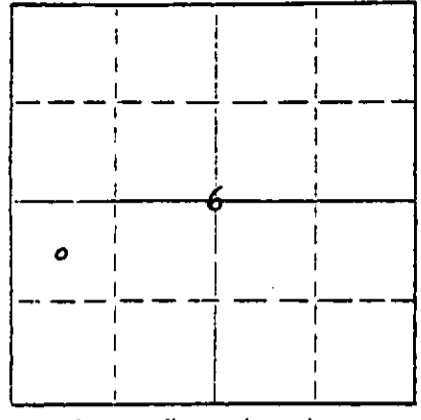

Locate well correctly on above Section Plat

If a producing well is abandoned, date of last production 19
Was permission obtained from the Conservation Division or its agents before plugging was commenced? Yes

Name of Conservation Agent who supervised plugging of this well Carl Goodrow
Producing formation Depth to top Bottom Total Depth of Well 4560 Feet
Show depth and thickness of all water, oil and gas formations.

OIL, GAS OR WATER RECORDS

CASING RECORD

FORMATION	CONTENT	FROM	TO	SIZE	PUT IN	PULLED OUT
		surface	289'	8 5/8"		

Describe in detail the manner in which the well was plugged, indicating where the mud fluid was placed and the method or methods used in introducing it into the hole. If cement or other plugs were used, state the character of same and depth placed, from feet to feet for each plug set.

1st plug @ 1260' w/70 sx
2nd plug @ 300' w/40 sx
Top plug @ 40' w/10 sx
10 sx in Rat Hole

(If additional description is necessary, use BACK of this sheet)

Name of Plugging Contractor Sun Oil Well Cementing, Inc.
Address Box 169 Great Bend, Kansas 67530

STATE OF KANSAS COUNTY OF SEDGWICK

William R. Horigan (employee of owner) or (owner or operator) of the above-described well, being first duly sworn on oath, says: That I have knowledge of the facts, statements, and matters herein contained and the log of the above-described well as filed and that the same are true and correct. So help me God.



(Signature) William R. Horigan
WILLIAM R. HORIGAN 200 Douglas Bldg WICHITA, KS
(Address) STATE CORPORATION COMMISSION 67202

Subscribed and sworn to before me this 16th day of February, 1982

My commission expires 06/12/82
Sherry L. Kendall
FEB 24 1982
Notary Public
Wichita, Kansas