


WELL PLUGGING RECORD

Give All Information Completely  
Make Required Affidavit  
Mail or Deliver Report to:  
Conservation Division  
State Corporation Commission  
211 No. Broadway  
Wichita, Kansas

Haskell County. Sec. 28 Twp. 28 Rge. 34 (E) (\*)  
Location as "NE/CNWSW" or footage from lines C/SE/NW  
Lease Owner Helmerich & Payne Inc.  
Lease Name EURANK Well No. 2  
Office Address First National Bldg., Tulsa, Okla.  
Character of Well (completed as Oil, Gas or Dry Hole) Oil & Gas  
Date well completed 10-2 19 58  
Application for plugging filed 4-28 19 62  
Application for plugging approved 4-28 19 62  
Plugging commenced 4-28 19 62  
Plugging completed 5-1 19 62  
Reason for abandonment of well or producing formation Non Commercial

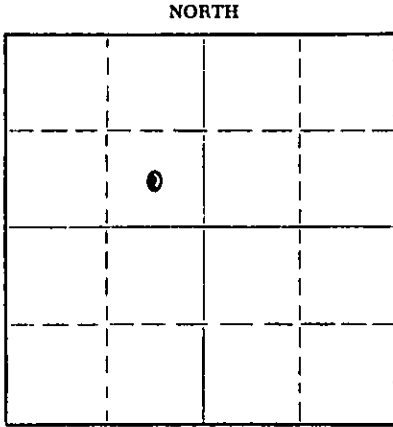

Locate well correctly on above Section Plat

If a producing well is abandoned, date of last production 9-11 19 61  
Was permission obtained from the Conservation Division or its agents before plugging was commenced? Yes

Name of Conservation Agent who supervised plugging of this well W. L. Lacamp Stafford, Kansas  
Producing formation Chester, & Kansas City Depth to top 5451 Bottom 4602 Total Depth of Well 5565 Feet  
Show depth and thickness of all water, oil and gas formations.

OIL, GAS OR WATER RECORDS

CASING RECORD

FORMATION	CONTENT	FROM	TO	SIZE	PUT IN	PULLED OUT
<u>Chester Sand C 5451-58</u>	<u>Oil</u>	<u>Surface</u>	<u>812</u>	<u>8-5/8"</u>	<u>812</u>	<u>0</u>
<u>Kansas City Lime 4590-4602</u>	<u>Gas</u>	<u>Surface</u>	<u>5565</u>	<u>5 1/2"</u>	<u>5565</u>	<u>2080'</u>

Describe in detail the manner in which the well was plugged, indicating where the mud fluid was placed and the method or methods used in introducing it into the hole. If cement or other plugs were used, state the character of same and depth placed, from \_\_\_\_\_ feet to \_\_\_\_\_ feet for each plug set.

Shot off casing @ 2080 and Pulled  
Plug back with sand from 5565 to 4575  
Dump 5 sacks of cement from 4575 to 4535  
Heavy Rotary mud from 4535 to 550'  
Set rock bridge (5') and dump 30 sacks cement from 550 to 475  
Heavy Rotary mud from 475 to 50'  
Set 5' rock bridge & 15 sacks of cement from 50 to base of cellar

5711-6000  
MAY 11 1962  
05-11-62  
CONSERVATION DIVISION  
Wichita, Kansas

(If additional description is necessary, use BACK of this sheet)

Name of Plugging Contractor Ace Pipe Pulling Co.  
Address Box 304, Great Bend, Kansas

STATE OF Kansas, COUNTY OF Finney, ss.  
T. E. Mort (employee of owner) or (owner or operator) of the above-described well, being first duly sworn on oath, says: That I have knowledge of the facts, statements, and matters herein contained and the log of the above-described well as filed and that the same are true and correct. So help me God.

(Signature) T. E. Mort  
Box 255 Garden City, Kansas  
(Address)

SUBSCRIBED AND SWORN TO before me this 7 day of May, 19 62

My commission expires July 1964

Robert N. Boyd  
Robert N. Boyd Notary Public.




WELL LOG BUREAU--KANSAS GEOLOGICAL SOCIETY  
508 East Murdock, Wichita, Kansas

Company- WHITE EAGLE OIL CO.  
Farm- Eubank No. 2

SEC. 28 T. 28 R. 34W  
C SE NW

Total Depth. 5635'  
Comm. 7-25-58 Comp. 10-31-58  
Shot or Treated.  
Contractor. R.W. Rine Drlg. Co.  
Issued. 11-29-58

County Haskell  
KANSAS

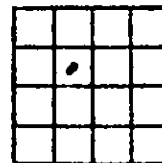

Elevation. 3032' RB

Production. 291 BOPD Phy. Pot.

CASING:

10" 800'  
5" 5565'

Figures Indicate Bottom of Formations.

clay, sand, shale	210
sand, gyp	396
shale, sand, shells	816
shale, sand	1743
shale, sand, Anhydrite	2030
shale, Anhydrite	2230
Anhydrite, dolomite	2310
lime, shale	2462
lime, shale	2737
shale, sand, lime	2763
lime shale	3510
lime	4112
lime, shale	4162
lime	4322
lime, shale	4386
lime	4660
lime, shale	4735
lime	4905
lime, shale	4968
lime	5243
lime, shale	5310
lime	5383
lime, shale	5635
Total Depth	

TOPS: ELECTRIC

Topeka Lime	3544
Heebner shale	4011
Toronto Lime	4029
Lansing Lime	4113
Marmaton	4619
Cherokec	4791
Morrow	5206
Chester	5439
Chester sand	5452
Chester Lime	5459
Ste. Genevieve	5488
St. Louis	5608