

STATE OF KANSAS
 STATE CORPORATION COMMISSION
 200 Colorado Derby Building
 Wichita, Kansas 67202

WELL PLUGGING RECORD
 K.A.R.-82-3-117

API NUMBER 15-051-19401-0000

LEASE NAME Baumer

WELL NUMBER B-27

TYPE OR PRINT
 NOTICE: Fill out completely
 and return to Cons. Div.
 office within 30 days.

2970 Ft. from S Section Line

330 Ft. from E Section Line

SEC. 27 TWP. 11S RGE. 17W (X for W)

COUNTY Ellis

Date Well Completed _____

Plugging Commenced _____

Plugging Completed 8-16-90

LEASE OPERATOR Phillips Petroleum Company

ADDRESS Box 20-A RT #3 Great Bend, KS. 67530

PHONE# (316) 793-8421 OPERATORS LICENSE NO. 5229

Character of Well Oil

(Oil, Gas, D&A, SWD, Input, Water Supply Well)

The plugging proposal was approved on _____ (date)

by _____ (KCC District Agent's Name).

Is ACO-1 filed? _____ If not, Is well log attached? _____

Producing Formation _____ Depth to Top _____ Bottom _____ T.D. 3416'

Show depth and thickness of all water, oil and gas formations.

OIL, GAS OR WATER RECORDS

CASING RECORD

Formation	Content	From	To	Size	Put In	Pulled out
				10 3/4"	1145'	none
				7"	3403'	none

Describe in detail the manner in which the well was plugged, indicating where the mud fluid was placed and the method or methods used in introducing it into the hole. If cement or other plugs were used, state the character of same and depth placed, from _____ feet to _____ feet each set.
Mixed 7 hulls with 300 sacks 60/40 8% gel. Max 300# pressure shut in 150# pressure.

(If additional description is necessary, use BACK of this form.)

Name of Plugging Contractor KELSO CASING PULLING, INC. License No. 6050

Address P.O. Box 347 Chase, Kansas 67524

NAME OF PARTY RESPONSIBLE FOR PLUGGING FEES: Phillips Petroleum Company 18 1990

STATE OF Kansas COUNTY OF Rice, ss. 09-18-90

R. Darrell Kelso (Employee of Operator) or (Operator) of above-described well, being first duly sworn on oath, says: That I have knowledge of the facts, statements, and matters herein contained and the log of the above-described well as filed that the same are true and correct, so help me God.

(Signature) [Signature]

(Address) P.O. Box 347 Chase, KS. 67524

SUBSCRIBED AND SWORN TO before me this 14 day of Sept., 19 90


[Signature]
 Notary Public

My Commission Expires: _____



WELL SCHEMATIC

GL _____
 KB 1941'
 PBTD _____
 TD 3416

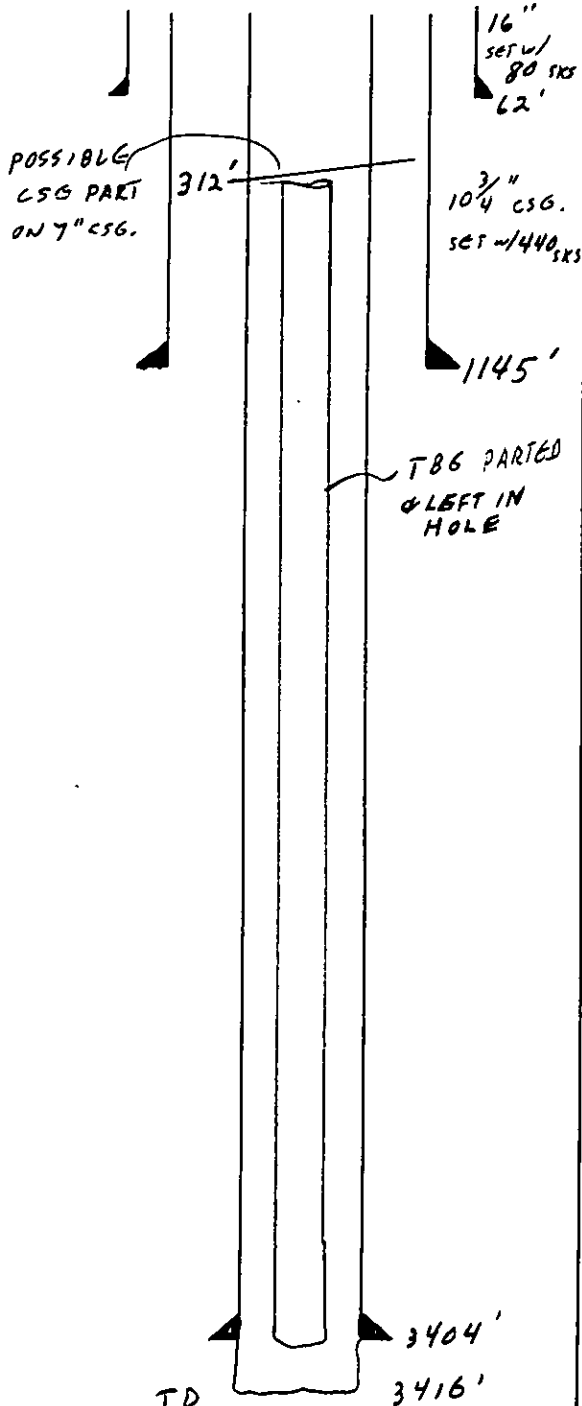

TD 3416'
 PREPARED BY: DAR
 DATE: 6/13/90

WELL DATA

WELL LOCATION BAUMER "A" 27 STATUS SD OIL
SE SE NE
SEC 27-T11S-R17W
ELLIS COUNTY, KS
 SPUD 12-30-37
 COMPLETED 1-21-38
 IP 1681 BPD

CASING	OD	WT	CEMENT	FROM	TO
			GRADE		
	16"	70#	80 SKS CIRC	62'	SURFACE
	10 3/4"	45# 35#	440 SKS	1145'	0
	7"	24#	175 SKS	3404'	0
TUBING	3 1/2"			312'	3404'

PERFS.	ZONE	TYPE	INTERVAL	SPF
	ARBuckle	OPEN HOLE	3404-16'	

LOGS	TYPE	DATE	COMPANY	FOOTAGE

WELL TEST	DATE	BOPD	MCFGPD	BWPD
FORMATION TOPS	ANHYDRITE	1135		
	HERRINGTON LS	1730		
	TARKIA	2625		
	TRPEKA	2780		
	LKC	3140		
	SIMPSON	3395		
	ARBuckle	3401		

SHUT DOWN 4/12/90 w/ TAG IN HOLE &
 POSSIBLE CSG PART ON 7" AT 312'