


WELL PLUGGING RECORD

Give All Information Completely
Make Required Affidavit
Mail or Deliver Report to:
Conservation Division
State Corporation Commission
800 Bitting Building
Wichita, Kansas

Ellis County, Sec. 27 Twp. 11 Rge. 17 (E) W. (W)

Location as "NE/CNW $\frac{1}{4}$ /SW $\frac{1}{4}$ " or footage from lines NW NW SW
Lease Owner DEEP ROCK OIL CORPORATION
Lease Name Baumer Well No. 15
Office Address Box #1051, Tulsa, Oklahoma
Character of Well (completed as Oil, Gas or Dry Hole) Dry
Date well completed August 15 19 37
Application for plugging filed September 29 19 51
Application for plugging approved October 1 19 51
Plugging commenced November 15 19 51
Plugging completed November 30 19 51
Reason for abandonment of well or producing formation

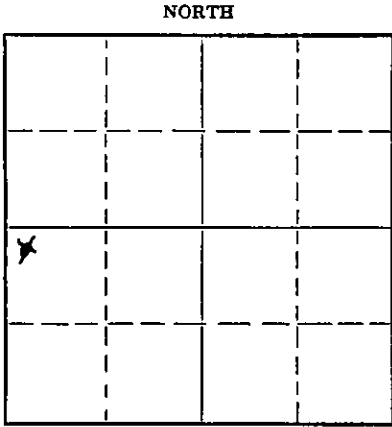

Locate well correctly on above Section Plat

If a producing well is abandoned, date of last production 19
Was permission obtained from the Conservation Division or its agents before plugging was commenced? Yes

Name of Conservation Agent who supervised plugging of this well Mr. Eldon Petty
Producing formation Depth to top Bottom Total Depth of Well 3721' P.B. 3656'
Show depth and thickness of all water, oil and gas formations.

OIL, GAS OR WATER RECORDS

CASING RECORD

Formation	Content	From	To	Size	Put In	Pulled Out
				15 $\frac{1}{2}$ "	28'	None
				10"	1300'	None
				7"	3655'	2854'

Describe in detail the manner in which the well was plugged, indicating where the mud fluid was placed and the method or methods used in introducing it into the hole. If cement or other plugs were used, state the character of same and depth placed, from feet to feet for each plug set.

Put in 2 sacks cement at 3646', filled to 3244', filled with sand from 3244' to 3221', put in 4 sacks cement, filled to 3209', Filled with heavy mud up to 250'. Set rock bridge and put in 20 sacks cement, filled to 200'. Put in heavy mud filled to 175'. Put in 10 sacks cement, filled to top of hole and into cellar.

DEC 11 1951 12-11-51
CC. WICHITA, KANSAS

(If additional description is necessary, use BACK of this sheet)
Name of Plugging Contractor L & F Casing Pulling Company
Address Box #294, Russell, Kansas

STATE OF Kansas, COUNTY OF Reno, ss.
Jack Smith (employee of owner) or (owner) of the above-described well, being first duly sworn on oath, says: That I have knowledge of the facts, statements, and matters herein contained and the log of the above-described well as filed and that the same are true and correct. So help me God.

(Signature) Jack Smith
Box #1146, Hutchinson, Kansas (Address)

SUBSCRIBED AND SWORN to before me this 10th day of December, 1951

My commission expires August 15, 1952
Notary Public

27.11.1951
100

0	50	Lime
50	435	Lime & Shale
435	515	Shale
515	540	Sand
540	650	Shale
650	700	Sand
700	735	Shale
735	880	Shale & Lime Shells
880	955	Sand
955	1010	Shale & Shells
1010	1255	Shale, strks of Sand
1255	1300	Shale
1300	1345	Anhydrite
1345	1395	Red rock
1395	1595	Shale
1595	1735	Shale & strks of Lime
1735	2000	Shale & Shells
2000	2020	Lime
2020	2070	Lime & Shale
2070	2195	Brkn lime shale
2195	2290	Broken lime
2290	2305	Lime hard
2305	2315	Sandy lime
2315	2365	Broken lime
2365	2400	Lime
2400	2550	Shale
2550	2620	Shale lime
2620	2650	Lime
2650	2695	Brkn lime & shale
2695	2750	Brkn lime
2750	2845	Shale
2845	2865	Shale & lime broken
2865	2905	Lime
2905	2970	Brkn lime shale
2970	3020	Shale & shells
3020	3040	Lime broken
3040	3078	Broken lime
3078	3240	Lime
3240	3270	Lime hard
3270	3275	Lime broken
3275	3525	Lime
3525	3565	Lime K.C.
3565	3570	Lime
3570	3592	Broken lime
3592	3622	Broken lime & shale
3622	3630	Red rock
3630	3632	Lime
3632	3649	Porous Lime
3649	3658	Broken Lime & shale
3658	3659	Sand
3659	3663	Red rock
3663	3682	Red rock & lime
3682	3697	Granite Wash
3697	3698	Red Rock
3698	3700	Hard Lime
3700	3701	Granite Wash-hard

3701	3711	Red rock & Granite
3711	3721	Granite Wash
3721		Total Depth.

Plugged back from 3721' to 3646'
 with 35 sacks cement.

PLUGGING
 FILE SEC 27 T 11 R 170
 BOOK PAGE 18 LINE 1