

STATE CORPORATION COMMISSION OF KANSAS
OIL & GAS CONSERVATION DIVISION
WELL COMPLETION OR RECOMPLETION FORM
ACO-1 WELL HISTORY
DESCRIPTION OF WELL AND LEASE

Operator: License # 5181
Name Donald C. Slawson
Address 104 S. Broadway
200 Douglas Bldg.
City/State/Zip Wichita, KS 67202

Purchaser

Operator Contact Person William R. Horigan
Phone (316) 263-3201

Contractor: License # 5657
Name Slawson Drilling Co.

Wellsite Geologist Jeff Stewart
Phone

Designate Type of Completion
 New Well Re-Entry Workover
 Oil SWD Temp Abd
 Gas Inj Delayed Comp.
 Dry Other (Core, Water Supply etc.)

If OWNED: old well info as follows:
Operator
Well Name
Comp. Date Old Total Depth

WELL HISTORY

Drilling Method:
 Mud Rotary Air Rotary Cable

3-14-87 3-22-87 3-22-87
Spud Date Date Reached TD Completion Date

4634'
Total Depth PBDT

Amount of Surface Pipe Set and Cemented at 360 feet
Multiple Stage Cementing Collar Used? Yes No
If yes, show depth set feet
If alternate 2 completion, cement circulated from feet depth to w/ SX cmt
Cement Company Name
Invoice #

API No. 15-109-20,437-00-00
County Logan
NE NE SW Sec 23 Twp 13S Rge 33W East X West

2280 Ft North from Southeast Corner of Section
2930 Ft West from Southeast Corner of Section
(Note: Locate well in section plat below)


Lease Name Stoll "T" Well # 1

Field Name

Producing Formation

Elevation: Ground 2967' KB 2973'

Section Plat

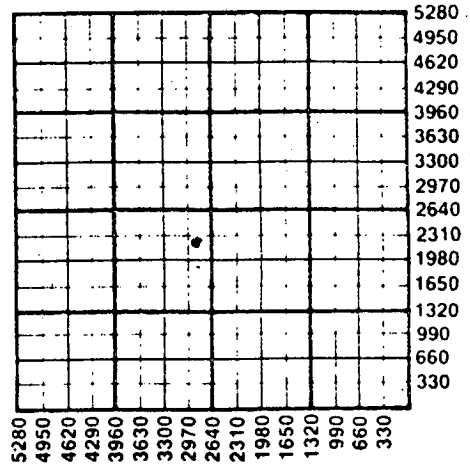

WATER SUPPLY INFORMATION

Disposition of Produced Water: Disposal
Docket # Repressuring

Questions on this portion of the ACO-1 call:
Water Resources Board (913) 296-3717

Source of Water:
Division of Water Resources Permit # 21,830

Groundwater Ft North from Southeast Corner (Well) Ft West from Southeast Corner of Sec Twp Rge East West

Surface Water Ft North from Southeast Corner (Stream, pond etc) Ft West from Southeast Corner SW /4 Sec 31 Twp 11S Rge 32 East X West

Other (explain) Willie Zerr (purchased from city, R.W.D. #)


INSTRUCTIONS: This form shall be completed in triplicate and filed with the Kansas Corporation Commission, 200 Colorado Derby Building, Wichita, Kansas 67202, within 120 days of the spud date of any well. Rule 82-3-130, 82-3-107 and 82-3-106 apply. Information on side two of this form will be held confidential for a period of 12 months if requested in writing and submitted with the form. See rule 82-3-107 for confidentiality in excess of 12 months. One copy of all wireline logs and drillers time log shall be attached with this form. Submit CP-4 form with all plugged wells. Submit CP-111 form with all temporarily abandoned wells.

All requirements of the statutes, rules and regulations promulgated to regulate the oil and gas industry have been fully complied with and the statements herein are complete and correct to the best of my knowledge.

Signature William R. Horigan
Title Kansas Operations Manager Date 4-3-87

Subscribed and sworn to before me this 3rd day of April 1987
Notary Public Elizabeth Cochran

Date Commission Expires

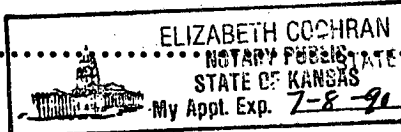

K.C.C. OFFICE USE ONLY
 Letter of Confidentiality Attached
 Wireline Log Received
 Drillers Timelog Received
Distribution
 KCC SWD/Rep NGPA
 KGS Plug Other (Specify)

RECEIVED
APR 23 1987
04-23-1987
CONSERVATION DIVISION
Wichita, Kansas