


STATE OF KANSAS  
STATE CORPORATION COMMISSION

WELL PLUGGING RECORD 15-651-2292-00-00

Give All Information Completely  
Make Required Affidavit  
Mail or Deliver Report to  
Conservation Division  
State Corporation Comm.  
245 North Water  
Wichita, KS 67202

Ellis County, Sec. 27 Twp. 13 Rge. 20 XE/W  
Location as "NE/CNW $\frac{1}{4}$ /SW $\frac{1}{4}$ " or footage from lines  
NW NE NE

Lease Owner J. B. Collins  
Lease Name Giebler B Well No. 4  
Office Address 1007 Cody Ave., Suite A, Hays, KS 67601  
Character of Well (Completed as Oil, Gas or Dry Hole)  
Dry Hole

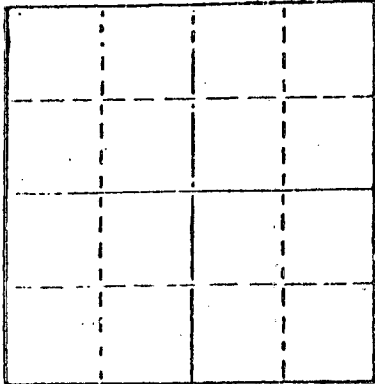

Date Well completed 12-17 1980  
Application for plugging filed 12-17 1980  
Application for plugging approved 12-17 1980  
Plugging commenced 12-17 1980  
Plugging completed 12-17 1980  
Reason for abandonment of well or producing formation

If a producing well is abandoned, date of last production 19

Was permission obtained from the Conservation Division or its agents before plugging was commenced? Yes

Name of Conservation Agent who supervised plugging of this well Marion Schmidt  
Producing formation Depth to top Bottom Total Depth of Well 3860'  
Show depth and thickness of all water, oil and gas formations.

OIL, GAS OR WATER RECORDS

CASING RECORD

FORMATION	CONTENT	FROM	TO	SIZE	PUT IN	PULLED OUT
				8 5/8"	168'	-0-

Describe in detail the manner in which the well was plugged, indicating where the mud fluid was placed and the method or methods used in introducing it into the hold. If cement or other plugs were used, state the character of same and depth placed, from feet to feet for each plug set.

1st plug @ 840' with 70 sacks cement  
2nd plug @ 150' with 25 sacks cement  
3rd plug @ 40' with 10 sacks cement

RECORDED  
STATE CORPORATION COMMISSION  
FEB - 4 1981 02-04-81

CONSERVATION DIVISION  
KANSAS

(If additional description is necessary, use BACK of this sheet)  
Name of Plugging Contractor Dreiling Oil, Inc.


STATE OF KANSAS COUNTY OF ELLIS, ss.

I, Joseph Hess, Sec-Treas. of Drlg. Contrc. (employee of owner) or (owner or operator) of the above-described well, being first duly sworn on oath, says: That I have knowledge of the facts, statements, and matters herein contained and the log of the above-described well as filed and that the same are true and correct. So help me God.

(Signature) Joseph A. Hess  
JOSEPH A. HESS, HAYS, KS 67601  
(Address)

SUBSCRIBED AND SWORN TO before me this 22nd day of December, 19 80

My commission expires August 30, 198  
Patty Dreiling  
Notary Public.

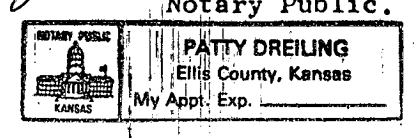

# DREILING OIL, INC.

Victoria, Kansas 67671

## WELL LOG

15-051-22192-00-00

Company J. B. Collins  
 1007 Cody Ave. Suite A  
 Hays, KS 67601

Farm Giebler B No. 4

Total Depth 3860'

Comm. 12-12-80 Comp. 12-17-80

Contractor Dreiling Oil, Inc.  
 Victoria, KS 67671

Sec. 27 Twp. 13 Rng. 20

Location NW NE NE

County Ellis

Elevation: 2212' K. B.  
 2209' D. F.  
 2207' G. R.

Casing Record 168" - 8 5/8"

Cement Record 135 sacks cement

Production:  
 D & A

### Figures Indicate Bottom of Formations

0'	60'	Top Soil - Post Rock
60'	103'	Shale
103'	173'	Shale
173'	1375'	Sand Streaks & Shale
1375'	1525'	Red Bed & Shale
1525'	1569'	Anhy.
1569'	1700'	Shale
1700'	2250'	Shale
2250'	2465'	Shale & Lime
2465'	2715'	Shale & Lime
2715'	2982'	Shale & Lime
2982'	3185'	Lime & Shale
3185'	3226'	Lime & Shale
3226'	3384'	Lime
3384'	3512'	Lime
3512'	3597'	Lime
3597'	3694'	Lime
3694'	3795'	Lime
3795'	3860'	Lime
3860'	T.D.	

STATE OF KANSAS)  
 )ss  
 COUNTY OF ELLIS)

I, Joseph A. Hess, Secretary Treasurer of Dreiling Oil, Inc., upon oath states that the above and foregoing is a true and copy from the Daily Drilling Report from the Giebler B-4.

*Joseph A. Hess*  
 JOSEPH A. HESS

Subscribed and sworn to before me this 22nd day of December, 1980.

*Patty Dreiling*  
 Patty Dreiling Notary Public

My commission expires: August 30, 1982.



RECEIVED  
 STATE OF KANSAS COMMISSION

FEB - 4 1981

CONSERVATION DIVISION