


STATE OF KANSAS
STATE CORPORATION COMMISSION

15-051-22141-00-00
WELL PLUGGING RECORD

Give All Information Completely
Make Required Affidavit
Mail or Deliver Report to
Conservation Division
State Corporation Comm.
245 North Water
Wichita, KS 67202

Ellis County, Sec. 27 Twp. 13 Rge. 20 NE/W
Location as "NE/CNW $\frac{1}{4}$ SW $\frac{1}{4}$ " or footage from lines _____
NW NW NE
Lease Owner J. B. Collins
Lease Name Giebler B Well No. 3
Office Address 1007 Cody Ave., Suite A, Hays, KS 67601
Character of Well (Completed as Oil, Gas or Dry Hole) _____

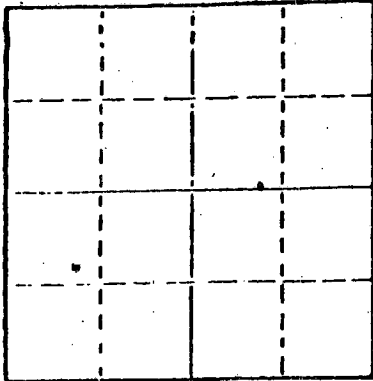

Locate well correctly on above
Section Plat

Dry Hole
Date Well completed 11-28 19 80
Application for plugging filed 11-28 1980
Application for plugging approved 11-28 1980
Plugging commenced 11-28 1980
Plugging completed 11-28 1980
Reason for abandonment of well or producing formation _____

If a producing well is abandoned, date of last production 19 _____

Was permission obtained from the Conservation Division or its agents before plugging was commenced? Yes

Name of Conservation Agent who supervised plugging of this well Marions Schmidt
Producing formation _____ Depth to top _____ Bottom _____ Total Depth of Well 3870'
Show depth and thickness of all water, oil and gas formations.

OIL, GAS OR WATER RECORDS

CASING RECORD


FORMATION	CONTENT	FROM	TO	SIZE	PUT IN	PULLED OUT
				8 5/8"	167'	0

Describe in detail the manner in which the well was plugged, indicating where the mud fluid was placed and the method or methods used in introducing it into the hold. If cement or other plugs were used, state the character of same and depth placed, from _____ feet to _____ feet for each plug set.

- 1st plug was set @ 840' w/70 sacks cement
- 2nd plug was set @ 150' w/25 sacks cement
- 3rd plug was set @ 40' w/10 sacks cement

(If additional description is necessary, use BACK of this sheet)

Name of Plugging Contractor Dreiling Oil, Inc.

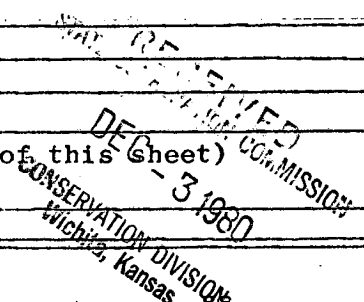

STATE OF KANSAS COUNTY OF ELLIS

I, Joseph A. Hess, Sec.-Treas. of Drlg. Contrc. (employee of owner) or (owner or operator) of the above-described well, being first duly sworn on oath, says: That I have knowledge of the facts, statements, and matters herein contained and the log of the above-described well as filed and that the same are true and correct. So help me God.

(Signature)

Joseph A. Hess
JOSEPH A. HESS, HAYS, KS 67601
(Address)

SUBSCRIBED AND SWORN TO before me this 2nd day of December, 1980

Patty Dreiling

Notary Public.

My commission expires August 30, 1980

Patty Dreiling



