


STATE OF KANSAS
STATE CORPORATION COMMISSION

Give All Information Completely
Make Required Affidavit
Mail or Deliver Report to:
Conservation Division
State Corporation Commission
212 North Market, Insurance Bldg.
Wichita, Kansas

R 15-051-0539600-00
WELL PLUGGING RECORD

Ellis County, Sec. 27 Twp. 13 Rge. (X) 20 (W)

NORTH

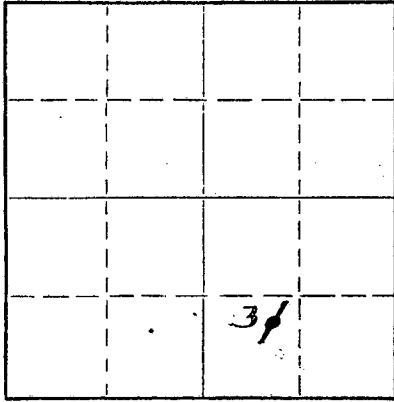

Locate well correctly on above
Section Plat

Location as "NE/CNW%SW%" or footage from lines NE SW SE
Lease Owner Cooperative Refinery Association
Lease Name Giebler "B" Well No. 3
Office Address Drawer "C", Great Bend, Kansas
Character of Well (completed as Oil, Gas or Dry Hole) Oil
Date well completed December 2 19 53
Application for plugging filed May 20 19 63
Application for plugging approved May 20 19 63
Plugging commenced June 22 19 63
Plugging completed June 22 19 63
Reason for abandonment of well or producing formation Non-commercial

If a producing well is abandoned, date of last production February 3 19 62
Was permission obtained from the Conservation Division or its agents before plugging was commenced? Yes

Name of Conservation Agent who supervised plugging of this well Eldon Petty
Producing formation Arbuckle Depth to top 3809 Bottom --- Total Depth of Well 3850 Feet
Show depth and thickness of all water, oil and gas formations.

OIL, GAS OR WATER RECORDS

CASING RECORD

FORMATION	CONTENT	FROM	TO	SIZE	PUT IN	PULLED OUT
Arbuckle	Oil & Water	3826	3832	8-5/8	255	None
				5-1/2	3850	None

Describe in detail the manner in which the well was plugged, indicating where the mud fluid was placed and the method or methods used in introducing it into the hole. If cement or other plugs were used, state the character of same and depth placed, from _____ feet to _____ feet for each plug set.

Coated 30 sacks of mud and 20 sacks of cement separated by a plug to 1040. Cement plug from 1040' to 1200'.

Casing shot at 400', pumped 23 sacks of mud and 18 sacks of cement separated by a plug. Cement plug from 4' to 148'. Maximum pressure 850#.

RECEIVED
STATE CORPORATION COMMISSION

JUL 3 1963

CONSERVATION DIVISION
Wichita, Kansas

(If additional description is necessary, use BACK of this sheet)

Name of Plugging Contractor Goble Oil Well Cementing, Inc.
Address P.O. Box 628, Great Bend, Kansas

STATE OF Kansas, COUNTY OF Barton, ss.
Paul M. Goodwin (employee of owner) or (owner or operator) of the above-described well, being first duly sworn on oath, says: That I have knowledge of the facts, statements, and matters herein contained and the log of the above-described well as filed and that the same are true and correct. So help me God.

(Signature) Paul M. Goodwin
Drawer "C", Great Bend, Kansas
(Address)

SUBSCRIBED AND SWORN to before me this 25th day of June, 19 63

My commission expires April 17, 1966

Donald Woods
Donald Woods

Notary Public.



L. B. Felt

DRILLERS LOG

Geibler "B" #3

Loc: NE SW SE

Sec: 27-13-20

Ellis County, Kansas.

Operator: Cooperative Refinery Assoc.

Contractor: Cooperative Refinery Assoc.

15-051-05396-00-00

Elevation: 2205 D.F.

Casing: 255' of 8-5/8"

2 1/2" new w/150 ex Permian 2 CC.

973.79' of 5 1/2" 15.50 JB and

2887.69' of 5 1/2" 1 1/2" JE set

at 3850 D.F. w/125 ex con.

Comm: 11-18-53 Comp: 12-2-53

Total Depth: 3850 D.F.

FEET	TO	FORMATION
0	255	Surface
255	420	Shale & Shells
420	1195	Sand, Shale & Shells
1195	1425	Shale, Shells & Red Bed
1425	1560	Shale & Lime
1560	1655	Shale
1655	2500	Shale & Lime
2500	2585	Lime
2585	3120	Lime & Shale
3120	3220	Lime
3220	3280	Lime & Shale
3280	3410	Lime
3410	3440	Lime & Shale
3440	3760	Lime
3760	3800	Lime & Shale
3800	3805	Lime
3805	3854 L.B.	Core
	3850 D.F.	RTD

STATE OF KANSAS

SS

COUNTY OF BARTON

I hereby certify that the above is a true and correct copy of the log on the Geibler "B" #3 well, located NE SW SE of Section 27-13-20 Ellis County, Kansas.

P. H. Jackson

Subscribed and sworn to before me this 7 day of Dec., 1953.

Donald Robert
Notary Public

My commission expires: Aug 17, 1957