


WELL PLUGGING RECORD

15-051-20176-00-00

Give All Information Completely
Make Required Affidavit
Mail or Deliver Report to:
Conservation Division
State Corporation Commission
212 No. Market
Wichita, Kansas

NORTH

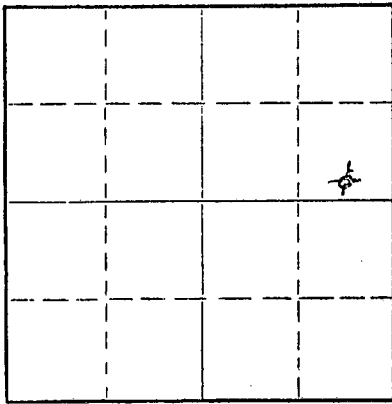

Locate well correctly on above Section Plat

ELLIS County. Sec. 34 Twp. 13 Rge. 20 (E) W (W)
Location as "NE/CNW*SW*" or footage from lines C S 1/2 SE NE
Lease Owner DANE G. HANSEN TR
Lease Name STORM B 2 Well No. _____
Office Address BOX 187, LOGAN, KANSAS 67646
Character of Well (completed as Oil, Gas or Dry Hole) DRY HOLE
Date well completed DEC. 11, 1967 19
Application for plugging filed DEC. 11, 1967 19
Application for plugging approved DEC. 11, 1967 19
Plugging commenced DEC. 11, 1967 19
Plugging completed DEC. 11, 1967 19
Reason for abandonment of well or producing formation TOO LOW STRUCTURALLY

If a producing well is abandoned, date of last production _____ 19
Was permission obtained from the Conservation Division or its agents before plugging was commenced? YES

Name of Conservation Agent who supervised plugging of this well LEO F MASSEY, HAYS, KANSAS
Producing formation _____ Depth to top _____ Bottom _____ Total Depth of Well 3863 Feet
Show depth and thickness of all water, oil and gas formations.

OIL, GAS OR WATER RECORDS

CASING RECORD

FORMATION	CONTENT	FROM	TO	SIZE	PUT IN	PULLED OUT
				8-5/8"	207.23'	None

Describe in detail the manner in which the well was plugged, indicating where the mud fluid was placed and the method or methods used in introducing it into the hole. If cement or other plugs were used, state the character of same and depth placed, from _____ feet to _____ feet for each plug set.

FILLED WITH HEAVY MUD TO 800'. SET PLUG. PUT IN 100 SACKS CEMENT. FILLED WITH HEAVY MUD TO 210'. SET PLUG. PUT IN 25 SACKS CEMENT. FILLED WITH HEAVY MUD UP TO 40'. SET PLUG. FILLED TO TOP WITH 1 1/2 sacks hulls and 10 SACKS CEMENT.

RECEIVED
DEC 22 1967
12-22-67
CONSERVATION DIVISION
WICHITA, KANSAS

(If additional description is necessary, use BACK of this sheet)
Name of Plugging Contractor C-G DRILLING CO.
Address 107 RULE BUILDING, WICHITA, KANSAS 67202

STATE OF KANSAS COUNTY OF SEDGWICK, ss.
G F GALLOWAY (employee of owner) or (owner or operator) of the above-described well, being first duly sworn on oath, says: That I have knowledge of the facts, statements, and matters herein contained and the log of the above-described well as filed and that the same are true and correct. So help me God.

(Signature) G F GALLOWAY

107 RULE BUILDING
(Address) WICHITA, KANSAS

SUBSCRIBED AND SWORN TO before me this 15th day of DECEMBER, 1967

My commission expires JAN. 23, 1968

Phyllis McJimsey
PHYLLIS McJIMSEY Notary Public.



WELL LOG

15-051-20176-00-00

OPERATOR: DANE G HANSEN TR

WELL NAME: STORM B2 LOCATION: C S $\frac{1}{2}$ SE NE

COUNTY: ELLIS STATE: KANSAS

WELL COMMENCED: DEC 3, 1967 WELL COMPLETED: DEC 11, 1967

ELEVATION: 2226 KB TOTAL DEPTH: 3863'

PRODUCTION: DRY AND ABANDONED RIG NO: #1

CASING - 8-5/8": 10 its. 207.23' W/140 SACKS QUICKSET

5-1/2":

All Measurements taken from the top of rotary bushing.

FROM	TO	FORMATION	DEVIATION FROM VERTICAL	REMARKS:
207	1230	SHALE & SAND	1° 1060'	DST. #1 3858 - 3863
1230	1305	RED BED	3/4° 1500'	
1305	1518	RED BED & SHALE	1° 2030'	
1518	1563	ANHYDRITE	1° 2510'	
1563	2100	SHALE & SHELLS	1° 2965'	
2100	3555	LIME & SHALE	1° 3355'	
3555	3745	LIME		
3745	3863	LIME & SHALE		

RECEIVED
STATE CORPORATIONS COMMISSION
DEC 22 1967

CONSERVATION DIVISION
Wichita, Kansas

STATE OF KANSAS
COUNTY OF SEDGWICK) SS:

The undersigned hereby certifies that to the best of his knowledge and belief, the above facts are true and correct.

C-G DRILLING CO.

By G F Galloway

G F GALLOWAY

SUBSCRIBED AND SWORN TO, BEFORE ME, This 15th day of DEC., 1967.



My comm. exp: Jan. 23, 1968

Phyllis McJimsey
Phyllis McJimsey -- Notary Public