


Give All Information Completely
Make Required Affidavit
Mail or Deliver Report to:
Conservation Division
State Corporation Commission
211 No. Broadway
Wichita, Kansas

15-051-30234-00-00
WELL PLUGGING RECORD

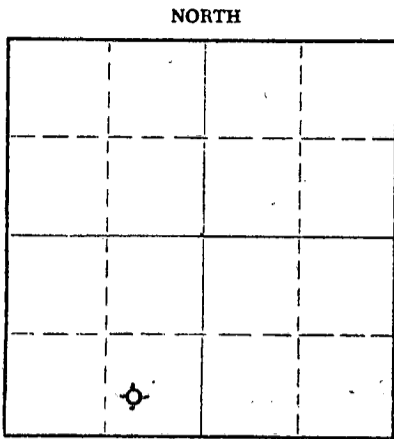

Locate well correctly on above
Section Plat

ELLIS County. Sec. 34 Twp. 13S Rge. 20 (E) W (W)
Location as "NE/CNW/SW" or footage from lines SW $\frac{1}{4}$ SE $\frac{1}{4}$ SW $\frac{1}{4}$
Lease Owner C-G Drilling Co.
Lease Name Nicholson Well No. 1
Office Address 107 Rule Building, Wichita, Kansas
Character of Well (completed as Oil, Gas or Dry Hole) dry hole
Date well completed 11/6/65 19
Application for plugging filed " 19
Application for plugging approved " 19
Plugging commenced " 19
Plugging completed " 19
Reason for abandonment of well or producing formation Too low structurally

If a producing well is abandoned, date of last production _____ 19
Was permission obtained from the Conservation Division or its agents before plugging was commenced? yes

Name of Conservation Agent who supervised plugging of this well Gilbert Leiker
Producing formation _____ Depth to top _____ Bottom _____ Total Depth of Well _____ Feet
Show depth and thickness of all water, oil and gas formations.

OIL, GAS OR WATER RECORDS

CASING RECORD

FORMATION	CONTENT	FROM	TO	SIZE	PUT IN	PULLED OUT
		0	209'	8-5/8"	209'	-

Describe in detail the manner in which the well was plugged, indicating where the mud fluid was placed and the method or methods used in introducing it into the hole. If cement or other plugs were used, state the character of same and depth placed, from _____ feet to _____ feet for each plug set.

Filled with heavy mud to 540'. Set plug with 20 sx cmt. Filled with heavy mud to 200'. Set plug with 20 sx cmt & 1/2 sx hulls. Filled with heavy mud to 40'. Set plug with 10 sx cmt & 1/2 sx hulls (cement to top of hole).

RECEIVED
STATE CORPORATION COMMISSION

NOV 15 1965

CONSERVATION DIVISION
Wichita, Kansas

(If additional description is necessary, use BACK of this sheet)


Name of Plugging Contractor _____
Address _____

STATE OF Kansas, COUNTY OF Sedgwick, ss.
Jay H. Galloway (employee or owner) or (owner or operator) of the above-described well, being first duly sworn on oath, says: That I have knowledge of the facts, statements, and matters herein contained and the log of the above-described well as filed and that the same are true and correct. So help me God.

(Signature) Jay H. Galloway
107 Rule Building, Wichita, Kansas (Address)

Subscribed and sworn to before me this 8th day of November, 1965
My commission expires May 20, 1967

Vicky Jacobs
Vicky Jacobs Notary Public.

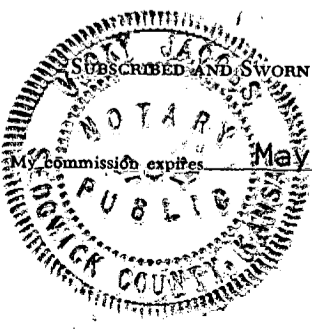

15-051-30234-00-00

WELL LOG

OPERATOR: C G DRILLING CO.

WELL NAME: NICHOLSON #1 LOCATION: SW/4 SE/4 SW/5 34-13S-20W

COUNTY: ELLIS STATE: KANSAS

WELL COMMENCED: OCT 27, 1965 WELL COMPLETED: NOV. 6, 1965

ELEVATION: 2286 K.B. TOTAL DEPTH: 3935'

PRODUCTION: Dry & abandoned RIG NO: 1

CASING - 8-5/8": 209' (6 Jts.) 20# New

5-1/2": _____

All Measurements taken from the top of rotary bushing.

FROM	TO	FORMATION	DEVIATION FROM VERTICAL	REMARKS:
0	209	Sand-Shale		
209	870	Shale		
870	1030	Shale-Sand		
1030	1270	Sand		
1270	1580	Shale-Red Bed		
1580	1582	Shale		
1582	1620	Anhydrite		
1620	1950	Shale-Shells		
1950	2140	Shale-Shells		
2140	2165	Lime-Shale	2170 - 2°	
2165	3620	Lime-Shale	2250 - 1-3/4°	DST #1: 3580-3625
			2310 - 1-1/4°	DST #2: 3881-3905
			3100 - 1-1/4°	DST #3: 3881-3910
3620	3935	Lime		

RECEIVED
STATE CORPORATION COMMISSION

NOV 15 1965

CONSERVATION DIVISION
Wichita, Kansas

STATE OF KANSAS)
COUNTY OF SEDGWICK) SS:

The undersigned hereby certifies that to the best of his knowledge and belief, the above facts are true and correct.

C-G DRILLING CO.

By Jay H. Galloway

SUBSCRIBED AND SWORN TO, BEFORE ME, This 8th day of November, 1965.

My comm. exp: May 20, 1967

Vicky Jacobs
Vicky Jacobs - Notary Public

