


Give All Information Completely
Make Required Affidavit
Mail or Deliver Report to:
Conservation Division
State Corporation Commission
212 No. Market
Wichita, Kansas

WELL PLUGGING RECORD

15-051-20230-00-00

NORTH

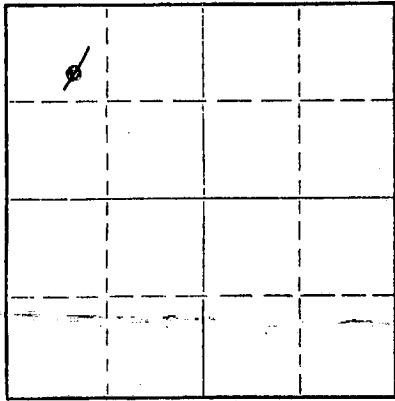

Locate well correctly on above Section Flat

Ellis County, Sec. 34 Twp. 13S Rge. (E) 20W(W)
Location as "NE/CNW%SW%" or footage from lines SE 1/4 NW 1/4 NW 1/4
Lease Owner Birmingham - Bartlett Drilling Co.
Lease Name Nicholson "C" Well No. 1
Office Address 300 Kaufman Bldg., Wichita, Kansas, 67202
Character of Well (completed as Oil, Gas or Dry Hole) Oil Well
Date well completed April 5, 1968
Application for plugging filed November 26, 1968
Application for plugging approved November 27, 1968
Plugging commenced November 30, 1968
Plugging completed December 8, 1968
Reason for abandonment of well or producing formation ~~Production declined to a point where well no longer economical to operate.~~
If a producing well is abandoned, date of last production November 13, 1968
Was permission obtained from the Conservation Division or its agents before plugging was commenced? Yes

Name of Conservation Agent who supervised plugging of this well Leo Massey
Producing formation Arbuckle Depth to top 3845' Bottom Total Depth of Well 3856 Feet
Show depth and thickness of all water, oil and gas formations.

OIL, GAS OR WATER RECORDS

CASING RECORD

FORMATION	CONTENT	FROM	TO	SIZE	PUT IN	PULLED OUT
		0	227'	8-5/8"	229'	None
		0	3849'	4-1/2"	3870' *	
	* being 2314' used & 1556' new X-Tru coat	4-1/2" OD	9.50# csg.			2911'

Describe in detail the manner in which the well was plugged, indicating where the mud fluid was placed and the method or methods used in introducing it into the hole. If cement or other plugs were used, state the character of same and depth placed, from feet to feet for each plug set.

Sand from 3866' up to 3840';- Run 3 sacks of cement 3840' up to 3800';- Shot pipe off at 2916';- Pulled pipe;

Plugging;- Pumped-by Sun Cementing Co. -- Thru 8 5/8" Casing, 20-Sacks Gel mud, 4-Sacks Hulls, 120 Sacks 50/50 Posmix Cement With 6% Gel. And 1- sack hulls, Top Plugged with 10-Sacks 50/50 Posmix, Mixed with 1 sak. Hulls, and 5 sacks gel mud. Filling 8 5/8" surface casing to base of the cellar;(3' below ground Level;

RECEIVED
STATE CORPORATION COMMISSION
DEC 16 1968
CONSERVATION DIVISION
Wichita, Kansas
(If additional description is necessary, use BACK of this sheet)

Name of Plugging Contractor * Glenn & Smith Pipe Pulling Co.
Address * Box 156, Ellinwood, Kansas

STATE OF KANSAS, COUNTY OF SEDGWICK, ss.
CHAS. H. KEEVERT (employee of owner) of the above-described well, being first duly sworn on oath, says: That I have knowledge of the facts, statements, and matters herein contained and the log of the above-described well as filed and that the same are true and correct. So help me God.

(Signature) Chas. H. Keevert
1806-Tracy Lane R-1, Hutchinson, Kans.
(Address)

SUBSCRIBED AND SWORN to before me this 13th day of December 1968
November 29, 1970
My commission expires



Vivian F. Yinger
Notary Public.

Birmingham - Bartlett Drilling Co. Check No. 42657 enclosed herewith in payment of your 12-9-68 Plugging Assessment Invoice No. 8964-W for \$38.56.

NICHOLSON 'C' NO. 1 WELL

LOCATION: SE $\frac{1}{4}$ NW $\frac{1}{4}$ NW $\frac{1}{4}$ Sec. 34-13S-20W
Ellis County, Kansas

OWNER, OPERATOR
and CONTRACTOR Birmingham-Bartlett Drilling Co.
300 Kaufman Bldg., Wichita, Kans.

SURFACE CASING: 8-5/8" 20# surface casing set
at 227' with 165 sacks cement.

OIL STRING: 2314' used and 1556' new X-Tru coat 4 $\frac{1}{2}$ "
OD 9.50# casing set at 3840' with 125
sacks cement 60/40 Posmix.

SPUDDED: 3-25-68
COMPLETED: 4-3-68

11505120230-00-00

LOG

(Figures indicate bottom of formation)

0 -	20	Shale & Clay
	32	Sand
	140	Shale & Shells
	227	Shale
	1040	Shale & Shells
	1250	Sand
	1549	Shale & Red Bed
	1592	Anhydrite
	1830	Shale & Shells
	2185	Shale
	2670	Lime & Shale
	2885	Shale & Lime Streaks
	3530	Lime & Shale
	3590	Lime
	3699	Lime & Shale
	3738	Lime
	3781	Lime & Shale
	3842	Lime
	3850	Lime & Shale
	3856	Arbuckle
	3856	Rotary Total Depth

RECEIVED
STATE CORPORATION COMMISSION
NOV 27 1968
CONSERVATION DIVISION
Wichita, Kansas

The undersigned, Richard Hindery, one of the partners of Birmingham-Bartlett Drilling Co., hereby certifies that the above is a true and correct log of the NICHOLSON 'C' NO. 1 WELL, as shown in the daily drilling reports.

BIRMINGHAM-BARTLETT DRILLING CO.

By Richard Hindery
Richard Hindery, Partner

Subscribed and sworn to before
me this 4th day of April, 1968.

Vivian F. Yinger
Vivian F. Yinger, Notary Public

My commission expires November 29, 1970.

