


WELL PLUGGING RECORD

Give All Information Completely  
Make Required Affidavit  
Mail or Deliver Report to:  
Conservation Division  
State Corporation Commission  
311 No. Broadway  
Wichita, Kansas

Ellis County, Sec. 36 Twp. 14 Rge. 16 (W)

NORTH

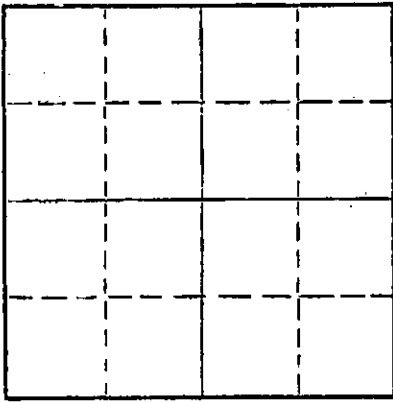

Locate well correctly on above  
Section Plat

Location as "NE/CNW/SW" or footage from lines C E/2 Sw  
Lease Owner Okmar Oil Company  
Lease Name Wagner Well No. 2  
Office Address 820 Union Nat'l. Bldg., Wichita  
Character of Well (completed as Oil, Gas or Dry Hole) dry hole  
Date well completed 11-15 1962  
Application for plugging filed 11-15 1962  
Application for plugging approved 11-15 1962  
Plugging commenced 11-15 1962  
Plugging completed 11-15 1962  
Reason for abandonment of well or producing formation dry hole

If a producing well is abandoned, date of last production \_\_\_\_\_ 19\_\_\_\_  
Was permission obtained from the Conservation Division or its agents before plugging was commenced? yes

Name of Conservation Agent who supervised plugging of this well Eldon Petty  
Producing formation \_\_\_\_\_ Depth to top \_\_\_\_\_ Bottom \_\_\_\_\_ Total Depth of Well 3445 Feet  
Show depth and thickness of all water, oil and gas formations.

OIL, GAS OR WATER RECORDS

CASING RECORD

FORMATION	CONTENT	FROM	TO	SIZE	PUT IN	PULLED OUT
				8 5/8	166'	

Describe in detail the manner in which the well was plugged, indicating where the mud fluid was placed and the method or methods used in introducing it into the hole. If cement or other plugs were used, state the character of same and depth placed, from \_\_\_\_\_ feet to \_\_\_\_\_ feet for each plug set.

Filled hole with heavy rotary mud  
Squeezed with 125 sacks cement

RECEIVED  
NOV 2 1962  
CONSERVATION DIVISION  
WICHITA, KANSAS  
11-19-1962

(If additional description is necessary, use BACK of this sheet)

Name of Plugging Contractor Woodman & Iannitti Drilling Co.  
Address 706 Union Nat'l. Bldg. Wichita

STATE OF Kansas, COUNTY OF Sedgwick, ss.  
K. T. Woodman (employee of owner) or (owner or operator) of the above-described well, being first duly sworn on oath, says: That I have knowledge of the facts, statements, and matters herein contained and the log of the above-described well as filed and that the same are true and correct. So help me God.

(Signature) K. T. Woodman

706 Union Nat'l. Bldg., Wichita  
(Address)

SUBSCRIBED AND SWORN TO before me this 16th day of November, 1962

My commission expires Oct. 10, 1963

Francis H. Solomon  
Francis H. Solomon Notary Public.

15-051-03856-00-00


KANSAS GEOLOGICAL SOCIETY  
KANSAS WELL LOG BUREAU - KANSAS WELL SAMPLE BUREAU  
KANSAS GEOLOGICAL SOCIETY BUILDING  
508 EAST MURDOCK - WICHITA, KANSAS

COMPANY Okmar Oil Company  
FARM Wagner NO. 2

SEC. 36 T. 11 N. R. 16 W  
LOC. C E/2 SW

TOTAL DEPTH 3445'  
COMM. 11-6-62 COMP. 11-15-62  
SHOT OR TREATED  
CONTRACTOR Woodman & Iannitti Drilling Co.  
ISSUED

COUNTY Ellis

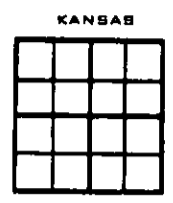

CASING  
20 10  
15 8 5/8" 166'  
12 6  
13 5

ELEVATION 1888 RB

PRODUCTION

FIGURES INDICATE BOTTOM OF FORMATIONS

- 0 - 80 Post Rock
- 130 Post Rock & Shale
- 475 Shale
- 625 Sand
- 975 Red Bed
- 1020 Anhydrite
- 1415 Red Bed, Shale & Shells
- 1725 Shale & Shells
- 2000 Shale & Lime
- 2045 Lime & Shale Stringers
- 2280 Lime
- 2835 Lime & Shale
- 3162 Lime
- 3180 Shale & Lime
- 3220 Lime
- 3255 Lime & Shale
- 3398 ~~Shale & Shells~~ Lime
- 3445 Conglomerate

RECEIVED  
STATE OF KANSAS  
NOV 11 1962  
11-19-1962  
CONSERVATION DIVISION  
WICHITA, KANSAS

I certify the above to be a true and correct copy of the Driller's Log to the best of my knowledge and belief.

WOODMAN & IANNITTI DRILLING COMPANY

By: K. T. Woodman  
K. T. Woodman