


Give All Information Completely
Make Required Affidavit
Mail or Deliver Report to:
Conservation Division
State Corporation Commission
311 No. Broadway
Wichita, Kansas

15-169-00116-00-00

WELL PLUGGING RECORD

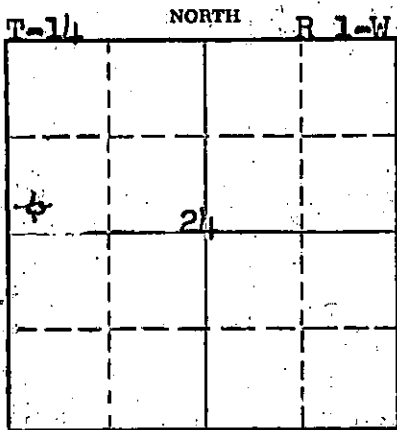

Locate well correctly on above Section Plat

Saline County. Sec. 24 Twp. 14 Rge. (E) 1 (W)
Location as "NE/CNWxSWx" or footage from lines C SW SW NW
Lease Owner Don McKellar et al
Lease Name Knight Well No. 1
Office Address 812 Hancock, Salina, Kansas
Character of Well (completed as Oil, Gas or Dry Hole) Dry Hole
Date well completed November 3, 19 59
Application for plugging filed November 3, 19 59
Application for plugging approved November 3, 19 59
Plugging commenced November 3, 1 19 59
Plugging completed November 3, 19 59
Reason for abandonment of well or producing formation dry

If a producing well is abandoned, date of last production 19
Was permission obtained from the Conservation Division or its agents before plugging was commenced? Yes

Name of Conservation Agent who supervised plugging of this well Cecil Jones
Producing formation Depth to top Bottom Total Depth of Well 2616 Feet
Show depth and thickness of all water, oil and gas formations.

OIL, GAS OR WATER RECORDS

CASING RECORD

FORMATION	CONTENT	FROM	TO	SIZE	PUT IN	PULLED OUT
				8 5/8"	124'	None

Describe in detail the manner in which the well was plugged, indicating where the mud fluid was placed and the method or methods used in introducing it into the hole. If cement or other plugs were used, state the character of same and depth placed, from feet to feet for each plug set.

Laid down drill pipe - filled hole - put bridge at 115 feet, then 15 sacks cement, then filled hole to within 20 feet of surface - put plug at 20 feet and 5 sacks of cement on top and 2 sacks of cement in rat-hole.

RECEIVED
STATE CORPORATION COMMISSION
NOV 12 1959
CONSERVATION DIVISION
11-12-1959

(If additional description is necessary, use BACK of this sheet)
Name of Plugging Contractor Donald T. Ingling
Address 623 1st Nat'l Bank Bldg., Wichita 2, Kansas

STATE OF KANSAS COUNTY OF SEDGWICK ss.
D. T. Ingling (employee of owner) or (owner or operator) of the above-described well, being first duly sworn on oath, says: That I have knowledge of the facts, statements, and matters herein contained and the log of the above-described well as filed and that the same are true and correct. So help me God.

(Signature) *D. T. Ingling*
623 1st Nat'l Bank Bldg., Wichita 2
(Address)

SUBSCRIBED AND SWORN to before me this 10th day of November, 19 59

M. E. Black
Notary Public.

My commission expires Feb. 27, 1960

15-169-00116-00-00

WELL LOG - KNIGHT NO. 1

Don McKellar et al, Lease Owner

Section 24-14-1W

Donald T. Ingling, Contractor

Location: C SW SW NW

Commenced: 10-27-59

County: Saline

Completed: 11-3-59

Production: Dry

Total Depth: 2616'

Elevation:

Casing: 8 5/8" 12 1/2" (60 sacks cement)

Figures below indicate bottom formation

- 40 surface clay
- 85 shale
- 124 shale and shells
- 260 lime
- 400 lime
- 565 lime
- 760 lime
- 1060 shale and shells
- 1290 shale and shells
- 1520 shale and shells
- 1660 lime
- 1765 lime
- 1815 lime
- 1887 sandy shale
- 1890 lime - Brown
- 1935 shale
- 2015 lime
- 2130 lime
- 2215 lime
- 2283 lime
- 2297 lime
- 2375 shale
- 2485 shale
- 2601 shale
- 2605 lime - Mississippi
- 2616 lime
- 2616 Total Depth

RECEIVED
STATE CORPORATION COMMISSION
NOV 7 1959

11-12-1959

I certify this is a true and correct copy of the above mentioned well.

STATE OF KANSAS)
SEDGWICK COUNTY) ss.

D. T. Ingling

Subscribed and sworn to before me, a Notary Public, in said county and state.

M. E. Beach
Notary Public

My commission expires: Feb. 27, 1960