


15-169-19021-00-00

Give All Information Completely  
Make Required Affidavit  
Mail or Deliver Report to:  
Conservation Division  
State Corporation Commission  
211 No. Broadway  
Wichita, Kansas

WELL PLUGGING RECORD

NORTH

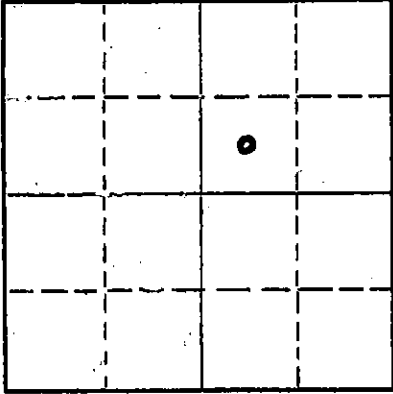

Locate well correctly on above  
Section Plot

Saline County, Sec. 30 Twp. 14 Rge. (E) 1 (W)  
Location as "NE/CNWxSWx" or footage from lines CS1 NE  
Lease Owner: SEH Oil Co.  
Lease Name: Sundholm Well No. 1  
Office Address: Route 73, Salina, Kansas,  
Character of Well (completed as Oil, Gas or Dry Hole) dry hole  
Date well completed 9/1 1964  
Application for plugging filed 9/1 1964  
Application for plugging approved 9/1 1964  
Plugging commenced 9/1 1964  
Plugging completed 9/1 1964  
Reason for abandonment of well or producing formation dry hole

If a producing well is abandoned, date of last production 19  
Was permission obtained from the Conservation Division or its agents before plugging was commenced? yes

Name of Conservation Agent who supervised plugging of this well Gilbert Toman  
Producing formation \_\_\_\_\_ Depth to top \_\_\_\_\_ Bottom \_\_\_\_\_ Total Depth of Well 2725 Feet  
Show depth and thickness of all water, oil and gas formations.

OIL, GAS OR WATER RECORDS

CASING RECORD

FORMATION	CONTENT	FROM	TO	SIZE	PUT IN	PULLED OUT
				8 5/8"	131'	

Describe in detail the manner in which the well was plugged, indicating where the mud fluid was placed and the method or methods used in introducing it into the hole. If cement or other plugs were used, state the character of same and depth placed, from \_\_\_\_\_ feet to \_\_\_\_\_ feet for each plug set.

heavy mud 2725' to 125'  
set wooden plug 125'  
20 sx cement on plug  
heavy mud to 40'  
set wooden plug 40'  
10sx cement on plug  
surface soil to 0'  
2sx cement in rat hole

RECEIVED  
STATE CORPORATION COMMISSION  
SEP 10 1964  
09-10-1964  
CONSERVATION DIVISION  
Wichita, Kansas

(If additional description is necessary, use BACK of this sheet)  
Name of Plugging Contractor Melland Drilling Co., Inc.  
Address Box 783, McPherson, Kansas

STATE OF Kansas COUNTY OF McPherson, ss.  
Donald J. Melland (employee of owner) or (owner or operator) of the above-described well, being first duly sworn on oath, says: That I have knowledge of the facts, statements, and matters herein contained and the log of the above-described well as filed and that the same are true and correct. So help me God.

(Signature) Donald J. Melland  
Box 783, McPherson, Kansas  
(Address)

SUBSCRIBED AND SWORN TO before me this 2nd day of September 1964

My commission expires December 23, 1967 Notary Public

15-109-19021-00-00

# WELL RECORD

LEASE: Sundblom

WELL NO. 1

ELEVATION: 1274 RB

LOCATION: CSW NE  
Sec. 30-14-1W

COMMENCED: 8/27/64

COMPLETED: 9/1/64

OPERATOR: S & H Oil Company

CONTRACTOR: Melland Drilling Company, Inc.  
Post Office Box 783  
McPherson, Kansas

CASING RECORD: 8 5/8" @ 131'/90sx

FORMATION	LOG
clay & shale	131
lime & shale	916
shale & shells	1545
shale & lime	2069
lime & shale	2531
shale & shells	2660
shale & lime	2725
RTD	2725

### Sample Tops

Lansing	2024
Mississippian	2690

FORMATION	LOG
-----------	-----

**RECEIVED**  
STATE CORPORATION COMMISSION  
09-10-1964  
SEP 10 1964  
CONSERVATION DIVISION  
Wichita, Kansas

## CERTIFICATE

State of Kansas, County of McPherson, ss.

I, Donald J. Melland, do hereby certify that the above is a true and correct copy of the log of the above named and described well, as reflected by the records of the Melland Drilling Company, Inc.

*Donald J. Melland*

Subscribed and sworn to before me, a Notary Public, in and for the County of McPherson, State of Kansas.

this 2nd day of September, 19 64.

*[Signature]*  
Notary Public

My Commission expires: December 23, 1967