

STATE OF KANSAS
STATE CORPORATION COMMISSION

WELL PLUGGING RECORD


Give All Information Completely
Make Required Affidavit
Mail or Deliver Report to:
Conservation Division
State Corporation Commission
809 Bittling Building
Wichita, Kansas

OR

FORMATION PLUGGING RECORD

Strike out upper line
when reporting plugging
off formations.

N 3-1/4 14-2-W

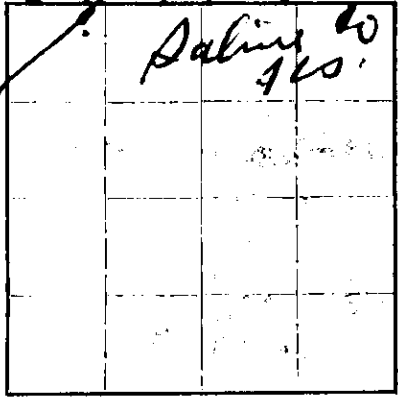

Locate well correctly on above
Section Plat

Saline County. Sec. 1 Twp. 14 Rge. 2 (E) 1/2 (W)
Location as "NE 1/4 NW 1/4 SW 1/4" on footage from lines 330 ft. N, 660 ft. W,
Lease Owner H. P. Stauffer
Lease Name H. P. Stauffer Well No. 1
Office Address P O 281 Saline, Mo.
Character of Well (completed as Oil, Gas or Dry Hole) Dry
Date well completed July 7 - 1947 19
Application for plugging filed 6-30-1947 19
Application for plugging approved 6-30-1947 19
Plugging commenced July 5 - 1947 19
Plugging completed July 7 - 1947 19
Reason for abandonment of well or producing formation Dry

If a producing well is abandoned, date of last production none 19
Was permission obtained from the Conservation Division or its agents before plugging was commenced? Yes

Name of Conservation Agent who supervised plugging of this well Ruel Durkee
Producing formation Depth to top Bottom Total Depth of Well 3406 feet

Show depth and thickness of all water, oil and gas formations.
OIL, GAS OR WATER RECORDS CASING RECORD

Formation	Content	From	To	Size	Put In	Pulled Out
Sand & Gravel	40"	48 ft.		20"		Left in hole
Shale & Rock	1481			15 1/2"		cut
Red Bed	1144			12 1/2"		cut
Shale & Lime	1173			10"		cut
Shale	2573			8"		cut
	3201			6 5/8"		600 ft. in hole

Describe in detail the manner in which the well was plugged, indicating where the mud fluid was placed and the method or methods used in introducing it into the hold. If cement or other plugs were used, state the character of same and depth placed, from _____ feet to _____ feet for each plug set.

hole was mudded to 210 feet from surface.
20 sacks cement. dumped on top of mud.
mudded to 20 feet of top. plug with steel +
old cable 10 feet thick - 10 sacks cement.
placed on top of plug - filled with
mud.

JUL 21 1947
OCT 21 1947

(If additional description is necessary use BACK of this sheet)

Correspondence regarding this well should be addressed to H. P. Stauffer
Address P O 281 Saline, Mo.

STATE OF Mo. COUNTY OF Saline, ss.
H. P. Stauffer (employee of owner) or (owner or operator) of the above-described well,
being first duly sworn on oath, says: That I have knowledge of the facts, statements, and matters herein contained and the log of the above-described well as filed and that the same are true and correct. So help me God.

(Signature) H. P. Stauffer
P O 281 Saline, Kansas (Address)

SUBSCRIBED AND SWORN to before me this 18 day of July 1947
J. P. Roberts Notary Public

My commission expires 11-5-47


PLUGGING
FILE NO. 1-14 R 2W
BOOK PAGE 112 LINE 32

15-16.9-00170-00-00

Central States Oil Co.
H.H.Meyer

H.D.Stauffer No 1.
Saline County
Sec. 1. T.14. R.2w.
NE. NE.

Total Depth 3406
Comm. 10-3-46 Comp. 6-27-47
Issued 7-2-47
Casing Record
20" 48'
15 1/2" 148'
12 1/2" 1144'
10" 1173'
8" 2573'
6" 3201'

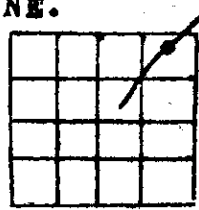

Elevation 1190'
Production. DRY.

Figures Indicate Bottom Of Formations.

Cellar	8	Shale	1595
Clay	27	Lime	1605
Sand	80	Shale	1610
Shale	140	Lime	1630
Lime	160	Shale	1645
Shale	195	Lime	1670
Lime	215	Shale	
Shale	225	Sand	1675
Red Rock	230	Lime	1690
Shale	235	Shale	1700
Red Rock	240	Lime Sandy	1725
Lime	250	Shale	1760
Shale	285	Lime	1775
Red Rock	310	Red Rock	1780
Lime	330	Shale	1930
Shale	340	Lime Sandy	1960
Lime	360	Lime	2040
Shale	375	Shale	2090
Lime	425	Lime	2175
Shale	495	Lime Sandy	2185
Lime	500	Shale	2205
Shale	520	Lime	2220
Lime	530	Shale	2230
Shale	570	Lime	2240
Lime	580	Shale	2245
Shale	595	Lime	2250
Lime	605	Shale&Lime	2575
Shale	670	Chat	2585
Lime	680	Lime	2765
Shale	685	Shale	2770
Lime	690	Lime	2810
Red Rock	735	Shale	2815
Shale	765	Lime	2820
Lime	770	Red Rock	2835
Shale	800	Shale	2855
Lime	810	Lime	2860
Shale	970	Shale	2980
Red Rock	975	Sand	2995
Shale	995	Lime	3115
Red Rock	1010	Shale	3201
Shale	1045	Lime	3320
Red Rock	1050	Shale	3323
Shale	1260	Lime Sandy	3388
Red Rock	1270	Lime	3406
Shale	1400		
Lime	1410		
Shale	1460		
Lime	1495		
Shale	1505		
Lime	1515		
Shale	1540		
Lime	1560		

07-21-1941

PLUGGING
NO. 114 R2W
ROCK 117 R32