


WELL PLUGGING RECORD

Give All Information Completely
Make Required Affidavit
Mail or Deliver Report to:
Conservation Division
State Corporation Commission
212 North Market, Insurance Bldg.
Wichita, Kansas

Saline County, Sec. 2, Twp. 14S, Rge. (E) 2 (W)

Location as "NE/CNW/SW" or footage from lines C NE/4 NW/4
Lease Owner Cal Jones
Lease Name Schenewerk Well No. 1
Office Address Canton, Kansas
Character of Well (completed as Oil, Gas or Dry Hole) Dry Hole
Date well completed February 24, 1962
Application for plugging filed February 24, 1962
Application for plugging approved FEB 24 1962
Plugging commenced February 24, 1962
Plugging completed February 24, 1962
Reason for abandonment of well or producing formation Dry Hole

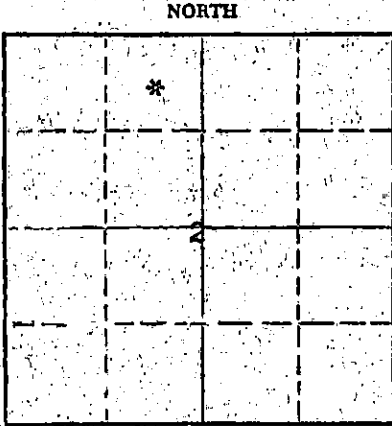

Locate well correctly on above Section Plat

If a producing well is abandoned, date of last production _____ 19____
Was permission obtained from the Conservation Division or its agents before plugging was commenced? Yes

Name of Conservation Agent who supervised plugging of this well Cecil Jones
Producing formation None Depth to top _____ Bottom _____ Total Depth of Well 3160 Feet
Show depth and thickness of all water, oil and gas formations.

OIL, GAS OR WATER RECORDS

CASING RECORD

FORMATION	CONTENT	FROM	TO	SIZE	PUT IN	PULLED OUT
				13-3/8"	94'	None
				8-5/8"	166'	None

Describe in detail the manner in which the well was plugged, indicating where the mud fluid was placed and the method or methods used in introducing it into the hole. If cement or other plugs were used, state the character of same and depth placed, from _____ feet to _____ feet for each plug set.

3160' to 165' - Heavy mud
165' - Set wood plug
165' to 90' - 25 sacks of cement
90' to 30' - Heavy mud
30' - Set wood plug
30' to 6' - 8 sacks of cement
6' to 0' - Surface soil

MADE BY 1562
CONS. DIV. REC. 02
03-13-1962

(If additional description is necessary, use BACK of this sheet)

Name of Plugging Contractor Kelland Drilling Company, Inc.
Address 1111 North Main Street, Hutchinson, Kansas

STATE OF _____, COUNTY OF _____, ss. _____ (employee of owner) or (owner or operator) of the above-described well, being first duly sworn on oath, says: That I have knowledge of the facts, statements, and matters herein contained and the log of the above-described well as filed and that the same are true and correct. So help me God.

(Signature) Orville J. Kelland

(Address)

SUBSCRIBED AND SWORN TO before me this 10 day of March, 1962

Jayne E. Mahes
Notary Public.

My commission expires 8/24/63

15-169-00194-00-00

DRILLER'S LOG

LEASE: Schenewerk

WELL NO. 1

LOCATION: C NE/4 NW/4
Sec. 2-14S-2W
Saline County, Kansas

COMMENCED: 2/14/62

COMPLETED: 2/24/62
(rotary)

OPERATOR: Cal Jones

CONTRACTOR: Melland Drilling Company, Inc.

CASING RECORD: 13-3/8" OD set at 94' with 131 sacks of cement & 3% calcium chloride.
8-5/8" OD set at 166' with 100 sacks of cement & 2% calcium chloride.

<u>FORMATION</u>	<u>LOG</u>
Surface soil & sand	80
Shale & gypsum	95
Shale	100
Anhydrite	166
Lime & shale	785
Shale	805
Shale & shells	1430
Lime & shale	1865
Sand	1903
Lime & shale	2357
Shale & lime	2480
Shale & shells	2570
Mississippi Lime	2750
Lime	2772
Shale	2929
Hunton Lime	2995
Lime	3045
Lime & shale	3160

RECEIVED
MAR 13 1962
03-13-1962
McPHERSON COUNTY
KANSAS

ROTARY TOTAL DEPTH
PB from 3160' to 165' with heavy mud;
PB from 165' to 90' with 25 sacks of
cement; PB from 90' to 30' with
heavy mud; PB from 30' to 6' with
8 sacks of cement; PB from 6' to
surface with surface soil. Plugged
and abandoned 2/24/62.

C E R T I F I C A T E

I, Donald J. Melland, do hereby certify that the above is a true and correct copy of the log of the Schenewerk well No. 1, located C NE/4 NW/4 Section 2-14S-2W, Saline County, Kansas, as reflected by the records of Melland Drilling Company, Incorporated.


Donald J. Melland

State of KANSAS)
) SS
COUNTY OF McPHERSON)

Subscribed and sworn to before me, a Notary Public, in and for McPherson County, Kansas, this 10 day of March, 1962.


Notary Public

My Commission Expires: 8/24/63