


WELL PLUGGING RECORD

Give All Information Completely
Make Required Affidavit
Mail or Deliver Report to:
Conservation Division
State Corporation Commission
800 Bittling Building
Wichita, Kansas

Saline County, Sec. 3 Twp. 14 Rge. (E) 2 (W)

Location as "NE/CNW/SW" or footage from lines C SE NE SE
Lease Owner Donald T. Ingling et al
Lease Name Prico Well No. 1
Office Address Wichita 2, Kansas
Character of Well (completed as Oil, Gas or Dry Hole) Dry Hole
Date well completed February 23 1956
Application for plugging filed February 23 1956
Application for plugging approved February 23 1956
Plugging commenced February 23 1956
Plugging completed February 23 1956
Reason for abandonment of well or producing formation Dry

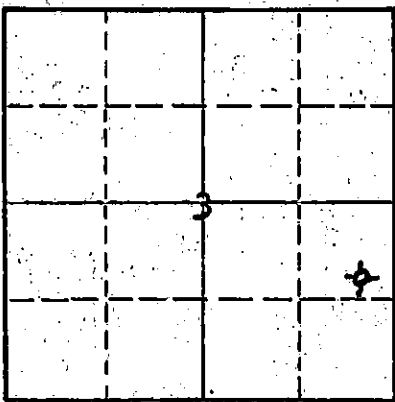

Locate well correctly on above Section Plat

If a producing well is abandoned, date of last production 19
Was permission obtained from the Conservation Division or its agents before plugging was commenced? Yes

Name of Conservation Agent who supervised plugging of this well Ruol Durkee
Producing formation _____ Depth to top _____ Bottom _____ Total Depth of Well 3176 Feet
Show depth and thickness of all water, oil and gas formations.

OIL, GAS OR WATER RECORDS

CASING RECORD

FORMATION	CONTENT	FROM	TO	SIZE	PUT IN	PULLED OUT
				8 5/8"	170'	None

Describe in detail the manner in which the well was plugged, indicating where the mud fluid was placed and the method or methods used in introducing it into the hole. If cement or other plugs were used, state the character of same and depth placed, from _____ feet to _____ feet for each plug set.

Gunned pits, circulated heavy mud one hour and laid down one-half drill pipe - circulated one-half hour and laid down balance of drill pipe. Bottom plug at 160 feet with 15 sacks cement and heavy mud, top plug at 20 feet with 5 sacks cement to surface. Plugging completed.

(If additional description is necessary, use BACK of this sheet)

Name of Plugging Contractor Donald T. Ingling
Address Wichita, Kansas

STATE OF KANSAS COUNTY OF SEDGWICK, ss.
D. T. Ingling (employee of owner) or (owner or operator) of the above-described well, being first duly sworn on oath, says: That I have knowledge of the facts, statements, and matters herein contained and the log of the above-described well as filed and that the same are true and correct. So help me God.

(Signature) D. T. Ingling
Wichita 2, Kansas (Address)

SUBSCRIBED AND SWORN TO before me this 24th day of February, 19 56
M. E. Beach

My commission expires Feb. 27, 1960 Notary Public.

RECEIVED
FEB 25 1956
02-25-1956
CONSERVATION DIVISION
WICHITA, KANSAS

PLUGGING
WELL SEC 3 14 R 2W
BOOK PAGE 41 LINE 30

Donald T. Ingling et al, Lease Owner	Section 3-14-2W
Donald T. Ingling, Contractor	Location: C SE NE SE
Commenced: 2- 8-56	County: Saline
Completed: 2-23-56	Production: Dry
Total Depth: 3176'	Elevation: 1200 DF
Casing: 8 5/8" 170' (100 sacks cement)	

Figures below indicate bottom formation

40 surface clay and sand	2320 lime
60 sand	2368 lime and shale streaks
105 shale	2413 lime and shale
170 lime	2470 shale
260 lime	2535 shale
380 lime	2572 shale
600 lime	2580 lime (Mississippi)
650 lime	2620 lime
720 red rock and shale	2680 lime - cherty
725 lime and shale	2737 lime
850 lime and shale	2770 lime (Mississippi)
1135 shale and shells	2778 lime
1340 shale and shells	2825 shale
1460 shale	2895 shale
1545 lime	2934 shale
1650 lime	2937 sand (Misener)
1725 lime	2957 lime (Hunton)
1760 lime	2992 lime
1790 shale and shells	3045 lime
1795 sand and shale	3090 shale
1830 shale	3120 shale
1846 shale	3147 lime (Maquodeta)
1849 lime (Brown)	3155 lime (Viola)
1906 shale	3176 lime
1920 lime (Lansing)	3176 Total Depth
1974 lime	
2035 lime	
2050 shale	
2115 lime	
2190 lime	
2245 lime	

I certify this is a true and correct copy of the above mentioned well.

STATE OF KANSAS)
 SEDGWICK COUNTY) ss.

Donald T. Ingling

Subscribed and sworn to before me, a Notary Public, in said county and state.

PLUGGING
 FILE SEC 3 T 14 R 2W
 BOOK PAGE 41 LINE 30

M.E. Black