


OR
FORMATION PLUGGING RECORD

Strike out upper line when reporting plugging off formations.

Give All Information Completely
Make Required Affidavit
Mail or Deliver Report to:
Conservation Division
State Corporation Commission
800 Bittling Building
Wichita, Kansas

Saline County. Sec. 6 Twp. 14 Rge. 2 (E) (W)
Location as "NE $\frac{1}{4}$ NW $\frac{1}{4}$ SW $\frac{1}{4}$ " or footage from lines. NE $\frac{1}{4}$ SE $\frac{1}{4}$ SW $\frac{1}{4}$
Lease Owner. Lowell Drilling Company, Inc. et al
Lease Name. Beverly Well No. 1
Office Address. 704 Petroleum Building, Wichita, Kansas
Character of Well (completed as Oil, Gas or Dry Hole) Dry Hole
Date well completed. May 5 19 47
Application for plugging filed. May 5 19 47
Application for plugging approved. May 5 19 47
Plugging commenced. May 11 19 47
Plugging completed. May 11 19 47
Reason for abandonment of well or producing formation. Dry Hole

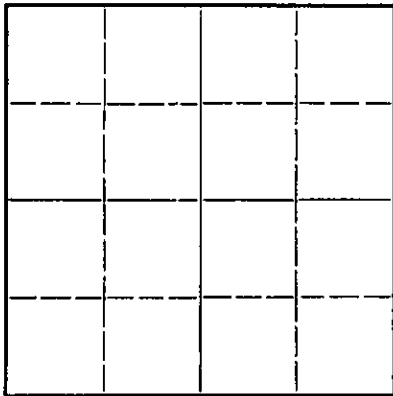

Locate well correctly on above Section Plat

If a producing well is abandoned, date of last production. 19
Was permission obtained from the Conservation Division or its agents before plugging was commenced? yes

Name of Conservation Agent who supervised plugging of this well. Ruel Durkee
Producing formation. Viola Depth to top. 3202 Bottom. 3204 Total Depth of Well. 3204 Feet
Show depth and thickness of all water, oil and gas formations.

OIL, GAS OR WATER RECORDS

CASING RECORD

Formation	Content	From	To	Size	Put In	Pulled Out
				8 5/8"	162'	None
				5 1/2"	3202'	1950'

Describe in detail the manner in which the well was plugged, indicating where the mud fluid was placed and the method or methods used in introducing it into the hole. If cement or other plugs were used, state the character of same and depth placed, from 3181 feet to 3204 feet for each plug set.
Cement plug set at bottom, 3181' to 3204', then hole filled with heavy mud to 159', cement plug with 15 sacks, heavy mud to top and cemented with 15 sacks. Cement at top

(If additional description is necessary, use BACK of this sheet)

Correspondence regarding this well should be addressed to. Lowell Drilling Company, Inc.
Address. 704 Petroleum Building, Wichita, Kansas

STATE OF Kansas, COUNTY OF Sedgwick, ss.
Lowell Drilling Company, Inc. (Employee or owner) or (owner or operator) of the above-described well,
being first duly sworn on oath, says: That I have knowledge of the facts, statements, and matters herein contained and the log of the above-described well as filed and that the same are true and correct. So help me God.

(Signature) by *Louis E. B. ...*
LOWELL DRILLING COMPANY, INC.
704 Petroleum Building, Wichita, Kansas

SUBSCRIBED AND SWORN to before me this 14th day of May, 1947

Pauline ...
Notary Public.

My commission expires February 26, 1951

PLUGGING
FILE SEC 6 T 14 R 2W
BOOK PAGE 109 LINE 28

15-169-00703-00-00

BEVERLY #1

NE/4 SE/4 SW/4 Section 6-14S-2W

Saline County, Kansas

LOWELL DRILLING COMPANY, INC. ET AL

Commenced: April 14, 1947
Completed: April 26, 1947

Clay & Sand	0	25
Shale & Lime	25	155
Anhydrite	155	162
Anhydrite & Shale	162	218
Lime, Shale & Sand Stks	218	335
Lime & Sand	335	360
Red bed	360	375
Lime & Stks. Sand	375	465
Lime & Shald	465	930
Shale & Shells	930	1185
Lime & Shale	1185	1400
Shale & Stks. Lime	1400	1545
Shale & Lime	1545	1645
Lime & Shale	1645	2100
Lime & Stks. Shale	2100	2175
Lime & Shale	2175	2465
Shale	2465	2565
Lime & Shale	2565	2670
Shale	2670	2694
Chert. & Lime	2694	2704
Cherty Lime & Shale	2704	2750
Cherty Lime & Shale		
Streaks	2750	2781
Cherty Lime & Shale	2781	2831
Lime & Shale Stks.	2831	2860
Shale & Stks. Lime	2860	2905
Shale	2905	2950
Lime & Shale	2950	3032
Lime	3032	3083
Lime & Shale	3083	3198
Shale	3198	3202
Viola Dolomite	3202	3204
TOTAL DEPTH	3204	

CASING RECORD

8 5/8" casing set at 162' and cemented with 100 sacks cement.

5 1/2" casing set at 3202' and cemented with 75 sacks cement.

STATE OF KANSAS)
) SS
COUNTY OF SEDGWICK)

I hereby affirm that the above and foregoing is a true and correct copy of the Log of Lowell Drilling Company, Inc. et al Beverly #1 well, located in the Northeast Quarter of the Southeast Quarter of the Southwest Quarter of Section 6, Township 14 South, Range 2 West, Saline County, Kansas.

LOWELL DRILLING COMPANY, INC.

By Emil C. Bauer
Secretary-Treasurer

Subscribed and sworn to before me, a Notary Public, this 30th day of April, 1947.

05-16-1947
Pauline Irnett
Notary Public

My commission expires February 26, 1951.

PLUGGING
FILE REC 6-T14-R2W
BOOK PAGE 102 LINE 28