


STATE OF KANSAS
STATE CORPORATION COMMISSION

WELL PLUGGING RECORD

Give All Information Completely
Make Required Affidavit
Mail or Deliver Report to
Conservation Division
State Corporation Comm.
245 North Water
Wichita, KS 67202

Saline County, Sec. 15 Twp. 14 Rge. 2 E
Location as "NE/CNW/SW" or footage from lines
C-SE-SE SW
Lease Owner Hutchinsons Oil Co
Lease Name Malmstrom Well No. 1
Office Address 1223 Douglas Bldg
Character of Well (Completed as Oil, Gas or Dry Hole) Dry Hole

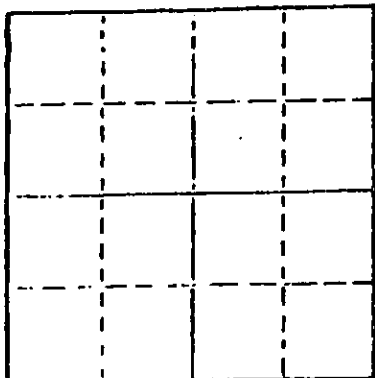

Locate well correctly on above Section Plot

Date Well completed 9-14-77 19
Application for plugging filed same 19
Application for plugging approved same 19
Plugging commenced 9-14-77 19
Plugging completed 9-14-77 19
Reason for abandonment of well or producing formation D/A

If a producing well is abandoned, date of last production 19

Was permission obtained from the Conservation Division or its agents before plugging was commenced? yes

Name of Conservation Agent who supervised plugging of this well _____
Producing formation _____ Depth to top _____ Bottom _____ Total Depth of Well 338'
Show depth and thickness of all water, oil and gas formations.

OIL, GAS OR WATER RECORDS

CASING RECORD

FORMATION	CONTENT	FROM	TO	SIZE	PUT IN	PULLED OUT
<u>SEE ATTACHMENT</u>						

Describe in detail the manner in which the well was plugged, indicating where the mud fluid was placed and the method or methods used in introducing it into the hold. If cement or other plugs were used, state the character of same and depth placed, from _____ feet to _____ feet for each plug set.

SEE ATTACHMENT

RECEIVED
STATE CORPORATION COMMISSION

OCT 26 1977
10-26-1977

CONSERVATION DIVISION

(If additional description is necessary use BACK of this sheet)

Name of Plugging Contractor Halliburton

STATE OF KANSAS COUNTY OF SEDGWICK, ss.
(employee of owner) or (owner or operator)
of the above-described well, being first duly sworn on oath, says: That I have knowledge of the facts, statements, and matters herein contained and the log of the above-described well as filed and that the same are true and correct. So help me God.

(Signature) Wm. S. Stachysan
1223 Douglas Bldg Wichita, KS
(Address) 67202

SUBSCRIBED AND SWORN TO before me this 24 day of October, 1977

James C. Hutchinson
Notary Public.

My commission expires _____

JAMES A. HUTCHINSON
STATE NOTARY PUBLIC
SEDGWICK COUNTY, KANSAS
My Comm. Exp. Sept. 25, 1978

A DIVISION OF HALLIBURTON COMPANY
FORM 1506-R4

P.O. DRAWER 1431
DUNCAN, OKLAHOMA 73533

15169-20080-00-00
PAGES NO. 214989

WELL NO. AND FAHM 1 Mainstream	COUNTY SALINE	STATE KANSAS	DATE 9-6-77
CHARGE TO HUTCHINSON'S OIL CO.	OWNER SAME	DUNCAN USE ONLY	
ADDRESS 1223 DOUGLAS BLDG.	CONTRACTOR TRANS-Amec	LOCATION McPherson	CODE 50350
CITY, STATE, ZIP WICHITA, KS 67202	SHIPPED VIA HOVISO	LOCATION 2 Filadelfo	CODE 50305
417150	DELIVERED TO Location	LOCATION 3	CODE
2	ORDER NO. Ch # 146	BULK MATERIAL DELIVERY TICKET NO. B-57204	
HUTCHINSON'S OIL CO 1223 DOUGLAS BLDG WICHITA, KS 67202	TOTAL ACID-30 DAYS	WELL TYPE 0:1 Dev	CODE 0.0
TYPE AND PURPOSE OF JOB SURFACE CSG 8 5/8" 166' SE SE SW 15 14S 2W			

TERMS: **NET** DUE BY THE 20TH OF FOLLOWING MONTH. INTEREST CHARGED AFTER 60 DAYS FROM DATE OF INVOICE.

PRICE REFERENCE	SECONDARY REF. OR PART NO.	CODE L D	DESCRIPTION	UNITS 1		UNITS 2		UNIT PRICE	AMOUNT
				QTY.	MEAS.	QTY.	MEAS.		
001-016			1K Pump Charge		MINI				270.00
000-117			1K Mileage		35 MI			1.10	38.50
000-502			1K Top Plug		1 PL	8 5/8"			25.20
27-43	2 R		Res. Portland		150 SLS			3.07	460.50
27-277	2 R		2% Gel		150			25	37.50
529-406	2 R		3% Cal Oil		4			13.30	53.20
PAID (13) SEP 15 1977									
HALLIBURTON SERVICES				CU. FT.		CU. FT.			
SERVICE CHARGE ON MATERIALS RETURNED									
530-277	2 R		SERVICE CHARGE		152			57	90.86
530-206	2 R		TOTAL WEIGHT 22		22			37	248.83
				LOADED MILES		TON MILES			

TAX REFERENCES

SUB TOTAL

1,223.79

WAS JOB SATISFACTORILY COMPLETED? _____
WAS OPERATION OF EQUIPMENT SATISFACTORY? _____
WAS PERFORMANCE OF PERSONNEL SATISFACTORY? _____

TAX _____
TAX _____
TAX _____

x **Bill Stubblefield**
Customer or His Agent

P.J. Venzoli
Halliburton Operator

TOTAL 1223.79

WELL NO. AND FAHM #1 Malstrom	COUNTY Salina	STATE Kansas	DATE 9-14-'77
CHARGE TO Hutchinson Oil Comp	OWNER Same	DUNCAN USE ONLY	
ADDRESS 1223 Douglas Bldg	CONTRACTOR Transamerica	LOCATION 1 McPherson	CODE 50350
CITY, STATE, ZIP Wichita Kansas	SHIPPED VIA Flowco	LOCATION 2 El Dorado	CODE 50305
DUNCAN USE ONLY HUTCHINSON'S OIL CO 1223 DOUGLAS BLDG WICHITA, KS 67202	DELIVERED TO location	LOCATION 3	CODE
	ORDER NO. 417150 2	BULK MATERIAL DELIVERY TICKET NO. B-524231	
	TOTAL ACID-30 DAYS	WELL TYPE oil development	CODE AD
	TYPE AND PURPOSE OF JOB set plug to abandon		
TERMS: NET DUE BY THE 20TH OF FOLLOWING MONTH. INTEREST CHARGED AFTER 60 DAYS FROM DATE OF INVOICE.			

PRICE REFERENCE	SECONDARY REF. OR PART NO.	CODE		DESCRIPTION	UNITS 1		UNITS 2		UNIT PRICE	AMOUNT
		L	D		QTY.	MEAS.	QTY.	MEAS.		
009-019		1	C	pump charge	175'	ft				270 00
000-117		1	C	mileage	40	mils			1.10	44 00
030-502		1	C	top plug LA 10	1	8 5/8			25.20	25 20
504-043		2	B	Reg Portland	37	sks			3.07	113 59
				SERVICE CHARGE ON MATERIALS RETURNED.					CU. FT.	
500-207		2	B	SERVICE CHARGE 1	37	CU. FT.			.57	21 09
500-306		2	B	TOTAL WEIGHT 3,478	92	LOADED MILES	159.99	TON MILES	.37	59 20

WAS JOB SATISFACTORILY COMPLETED? _____ WAS OPERATION OF EQUIPMENT SATISFACTORY? _____ WAS PERFORMANCE OF PERSONNEL SATISFACTORY? _____ x <i>[Signature]</i> Customer or His Agent				TAX REFERENCES 800-029 801-159 KANSAS <i>[Signature]</i> Halliburton Operator				SUB-TOTAL 533 08 TAX 4 16 TOTAL 537 24	
--	--	--	--	---	--	--	--	--	--