


Give All Information Completely
Make Required Affidavit
Mail or Deliver Report to:
Conservation Division
State Corporation Commission
P.O. Box 100
Topeka, Kansas

WELL PLUGGING RECORD

GOVE County, Sec. 33 Twp. 14s Rge. 27 (E) (W)

Location as "NE/CNW/SW" or footage from lines. NE NE
Lease Owner PETROLEUM, INC.
Lease Name CHENEY Well No. 1
Office Address R.R. #2, GREAT BEND, KANSAS
Character of Well (completed as Oil, Gas or Dry Hole) DRY HOLE
Date well completed SEPTEMBER 5 19 66
Application for plugging filed SEPTEMBER 5 19 66
Application for plugging approved SEPTEMBER 5 19 66
Plugging commenced SEPTEMBER 5 19 66
Plugging completed SEPTEMBER 5 19 66
Reason for abandonment of well or producing formation NO PRODUCIBLE ZONE

NORTH

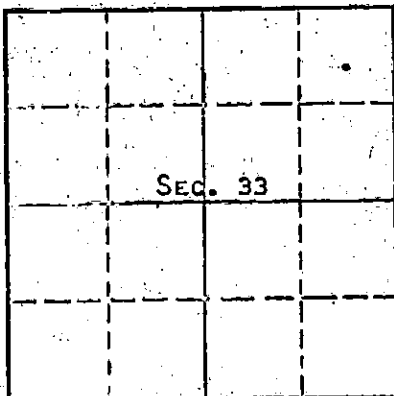

Locate well correctly on above
Section Plat

If a producing well is abandoned, date of last production NONE 19
Was permission obtained from the Conservation Division or its agents before plugging was commenced? YES

Name of Conservation Agent who supervised plugging of this well W. L. NICHOLS
Producing formation Depth to top Bottom Total Depth of Well 4352' Feet
Show depth and thickness of all water, oil and gas formations.

OIL, GAS OR WATER RECORDS

CASING RECORD

FORMATION	CONTENT	FROM	TO	SIZE	PUT IN	PULLED OUT
				8-5/8"	216'	NONE

Describe in detail the manner in which the well was plugged, indicating where the mud fluid was placed and the method or methods used in introducing it into the hole. If cement or other plugs were used, state the character of same and depth placed, from feet to feet for each plug set.

MUDDED UP WITH HEAVY MUD TO 480', FOLLOWED BY WOODEN PLUG, PLACED 20 SACKS CEMENT ON TOP OF PLUG. MUDDED UP WITH HEAVY MUD TO 210', FOLLOWED BY WOODEN PLUG, PLACED 10 SACKS CEMENT ON TOP OF PLUG THRU DRILL PIPE, MUDDED UP WITH HEAVY MUD TO 40', FOLLOWED BY WOODEN PLUG, PLACED 8 SACKS CEMENT ON TOP OF PLUG TO BASE OF WELL CELLAR.

RECEIVED
SEP 20 1966
09-22-66

(If additional description is necessary, use BACK of this sheet)
Name of Plugging Contractor GARVEY DRILLING COMPANY
Address R.R. #2, GREAT BEND, KANSAS

STATE OF KANSAS COUNTY OF BARTON ss.
MONTE CHADD, DIST. PROD. SUPT. (employee of owner) or (owner or operator) of the above-described well, being first duly sworn on oath, says: That I have knowledge of the facts, statements, and matters herein contained and the log of the above-described well as filed and that the same are true and correct. So help me God. MONTE CHADD, DIST. PROD. SUPT.

(Signature) [Signature]
ROUTE #2, GREAT BEND, KANSAS
(Address)

SUBSCRIBED AND SWORN to before me this 21 day of SEPTEMBER, 19 66

My commission expires MAY 28, 1969

[Signature]
Notary Public.

WELL LOG

COMPANY **Petroleum, Inc.**

SEC. **33 T. 14S R. 27W**

FARM **Cheney**

NO. **1**

LOC. **NE NE**

TOTAL DEPTH **4352'**


COUNTY **Gove**

COMM. **8-25-66**

COMP. **9-5-66**

CONTRACTOR **Garvey Drilling Company**

CASING **8 5/8" @ 216' w/160 sx**

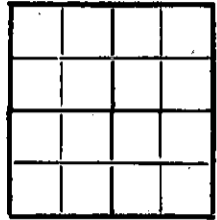

ELEVATION **2469' KB**

PRODUCTION **D & A**

FIGURES INDICATE BOTTOM OF FORMATIONS

- 35' Clay
- 75' Sand and Shale
- 1005' Shale
- 1180' Shale and Shells
- 1215' Anhydrite
- 1385' Red Bed and Shale
- 1695' Sand and Shale
- 1915' Shale
- 2210' Shale and Lime Streaks
- 2780' Shale and Lime
- 2875' Lime
- 3310' Lime and Shale
- 3355' Lime
- 3505' Chalk and Lime
- 3590' Lime
- 3665' Lime with Shale and Chalk Streaks
- 3760' Kansas City Lime
- 4203' Lime with Chert
- 4314' Lime
- 4352' Lime and Chert
- 4352' RTD

RECEIVED
STATE CORPORATION COMMISSION

SEP 23 1966

CONSERVATION DIVISION
TOPEKA, KANSAS

State of Kansas }
County of Barton } ss

I, Sam N. Stephens of Garvey Drilling Company

upon oath state the above and foregoing is a true and correct copy of the log of the Cheney No. 1 well.

Sam N. Stephens

Subscribed and sworn to before me this 20th day of September 19 66

My Commission Expires: November 5, 1969

Richard Doy
NOTARY PUBLIC