


STATE OF KANSAS  
STATE CORPORATION COMMISSION

Form CP-4

WELL PLUGGING RECORD

Give All Information Completely  
Make Required Affidavit  
Mail or Deliver Report to:  
Conservation Division  
State Corporation Commission

P. O. Box 17027  
Wichita, Kansas 67217  
NORTH

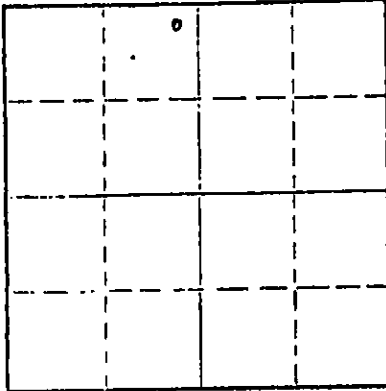

Locate well correctly on above  
Section Plat

Gove County, Sec. 33 Twp. 14S Rge. ~~27~~ 27 (W)  
Location as "NE/CNW/SW" or footage from lines NE NE NW  
Lease Owner American Petrofina Co. of Texas  
Lease Name COBERLY Well No. 1  
Office Address P.O. Box 18850  
Character of Well (completed as Oil, Gas or Dry Hole) Dry Hole  
Date well completed \_\_\_\_\_ 19\_\_\_\_  
Application for plugging filed Verbal by Dale Balthazar 2/16 1984  
Application for plugging approved \_\_\_\_\_ 2/16 1984  
Plugging commenced \_\_\_\_\_ 2/16 1984  
Plugging completed \_\_\_\_\_ 2/16 1984  
Reason for abandonment of well or producing formation Dry Hole  
If a producing well is abandoned, date of last production NA 19\_\_\_\_  
Was permission obtained from the Conservation Division or its agents before plugging was commenced? Yes

Name of Conservation Agent who supervised plugging of this well Dale Balthazar  
Producing formation NA Depth to top \_\_\_\_\_ Bottom \_\_\_\_\_ Total Depth of Well 4,350 Feet  
Show depth and thickness of all water, oil and gas formations.

OIL, GAS OR WATER RECORDS

CASING RECORD

FORMATION	CONTENT	FROM	TO	SIZE	PUT IN	PULLED OUT
Dakota Base		Surface	961'	8-5/8"	953'	0

Describe in detail the manner in which the well was plugged, indicating where the mud fluid was placed and the method or methods used in introducing it into the hole. If cement or other plugs were used, state the character of same and depth placed, from \_\_\_\_\_ feet to \_\_\_\_\_ feet for each plug set.

Set plugs as follows: 1930' - 25 sx 50/50 Pozmix, 6% gel, 3% Calcium. 1000' - 140 sx 50/50 Pozmix, 6% gel, 3% Calcium, 15 sx in top of surface - 15 sx in rathole.

RECEIVED  
STATE CORPORATION COMMISSION  
APR 10 1984  
CONSERVATION DIVISION  
Wichita, Kansas

(If additional description is necessary, use BACK of this sheet)

Name of Plugging Contractor Allied Cementers  
Address Russell, KS

STATE OF OKLAHOMA COUNTY OF OKLAHOMA, ss.

Dave Roddy (employee of owner) or (owner or operator) of the above-described well, being first duly sworn on oath, says: That I have knowledge of the facts, statements, and matters herein contained and the log of the above-described well as filed and that the same are true and correct. So help me God.

(Signature) David A. Roddy  
P.O. Box 18850, Oklahoma City, OK 73118  
(Address)

SUBSCRIBED AND SWORN to before me this 12th day of March, 1984

Raylene M. Smith  
Notary Public.